




three inches = one foot  
one and one half inches = one foot  
one inch = one foot  
three quarters inch = one foot  
one half inch = one foot  
three eighths inch = one foot  
one quarter inch = one foot  
one eighth inch = one foot  
one sixteenth inch = one foot

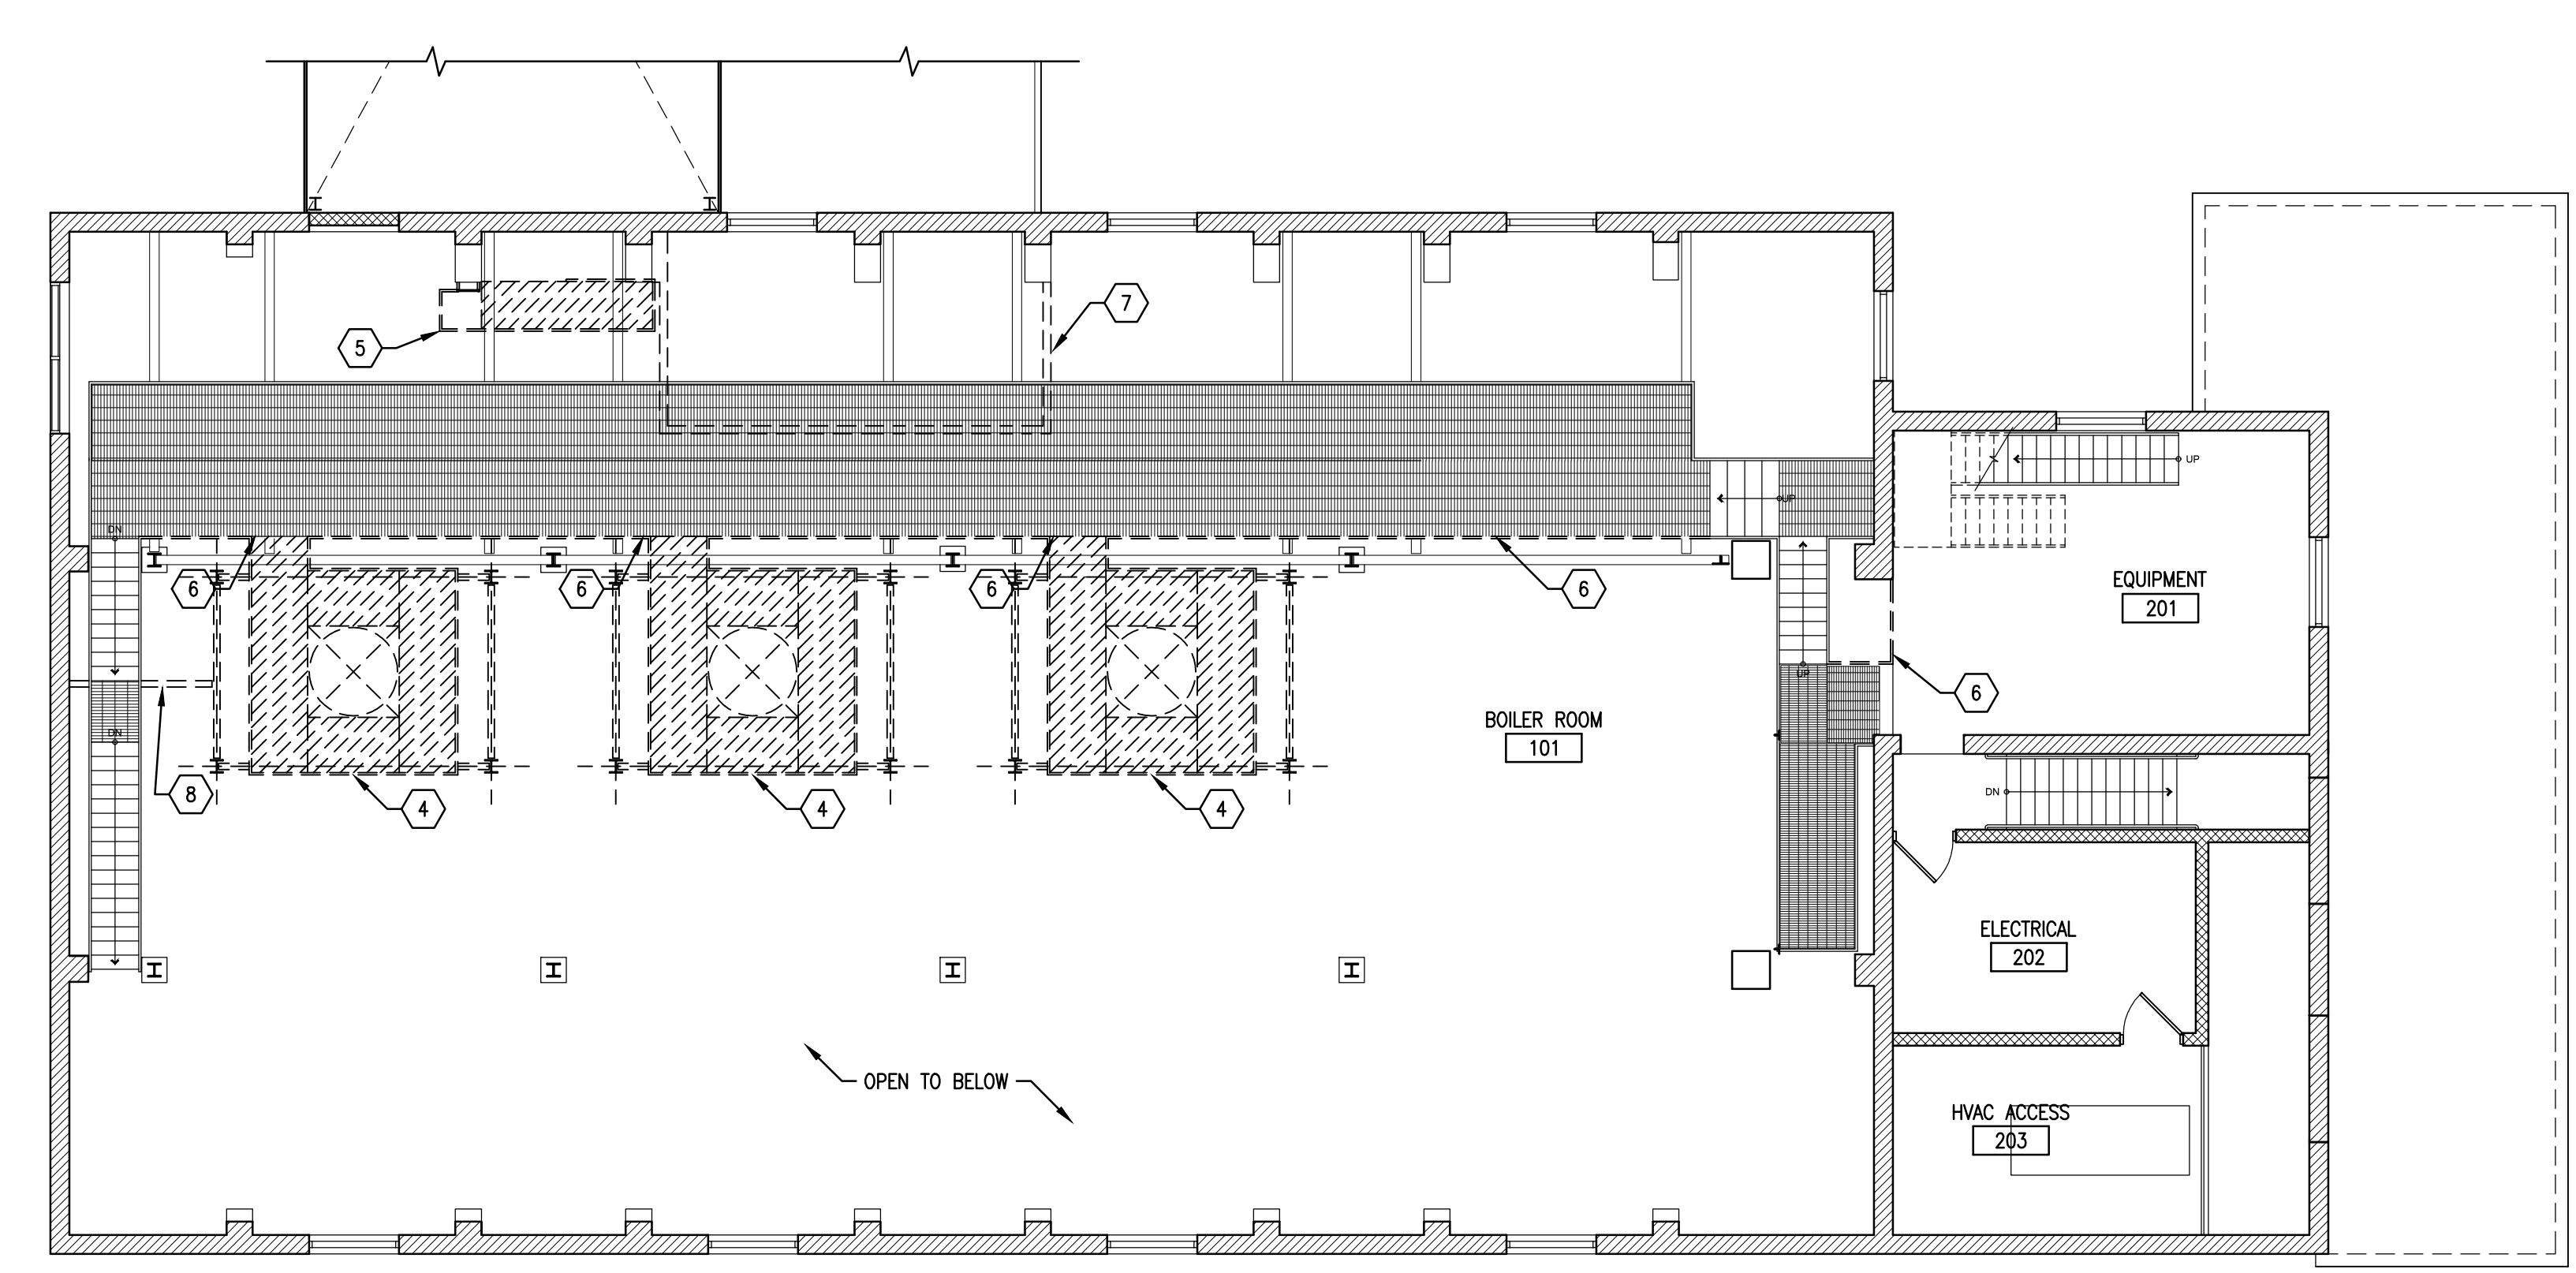


2 SECOND FLOOR DEMOLITION PLAN  
1/8" = 1'-0"

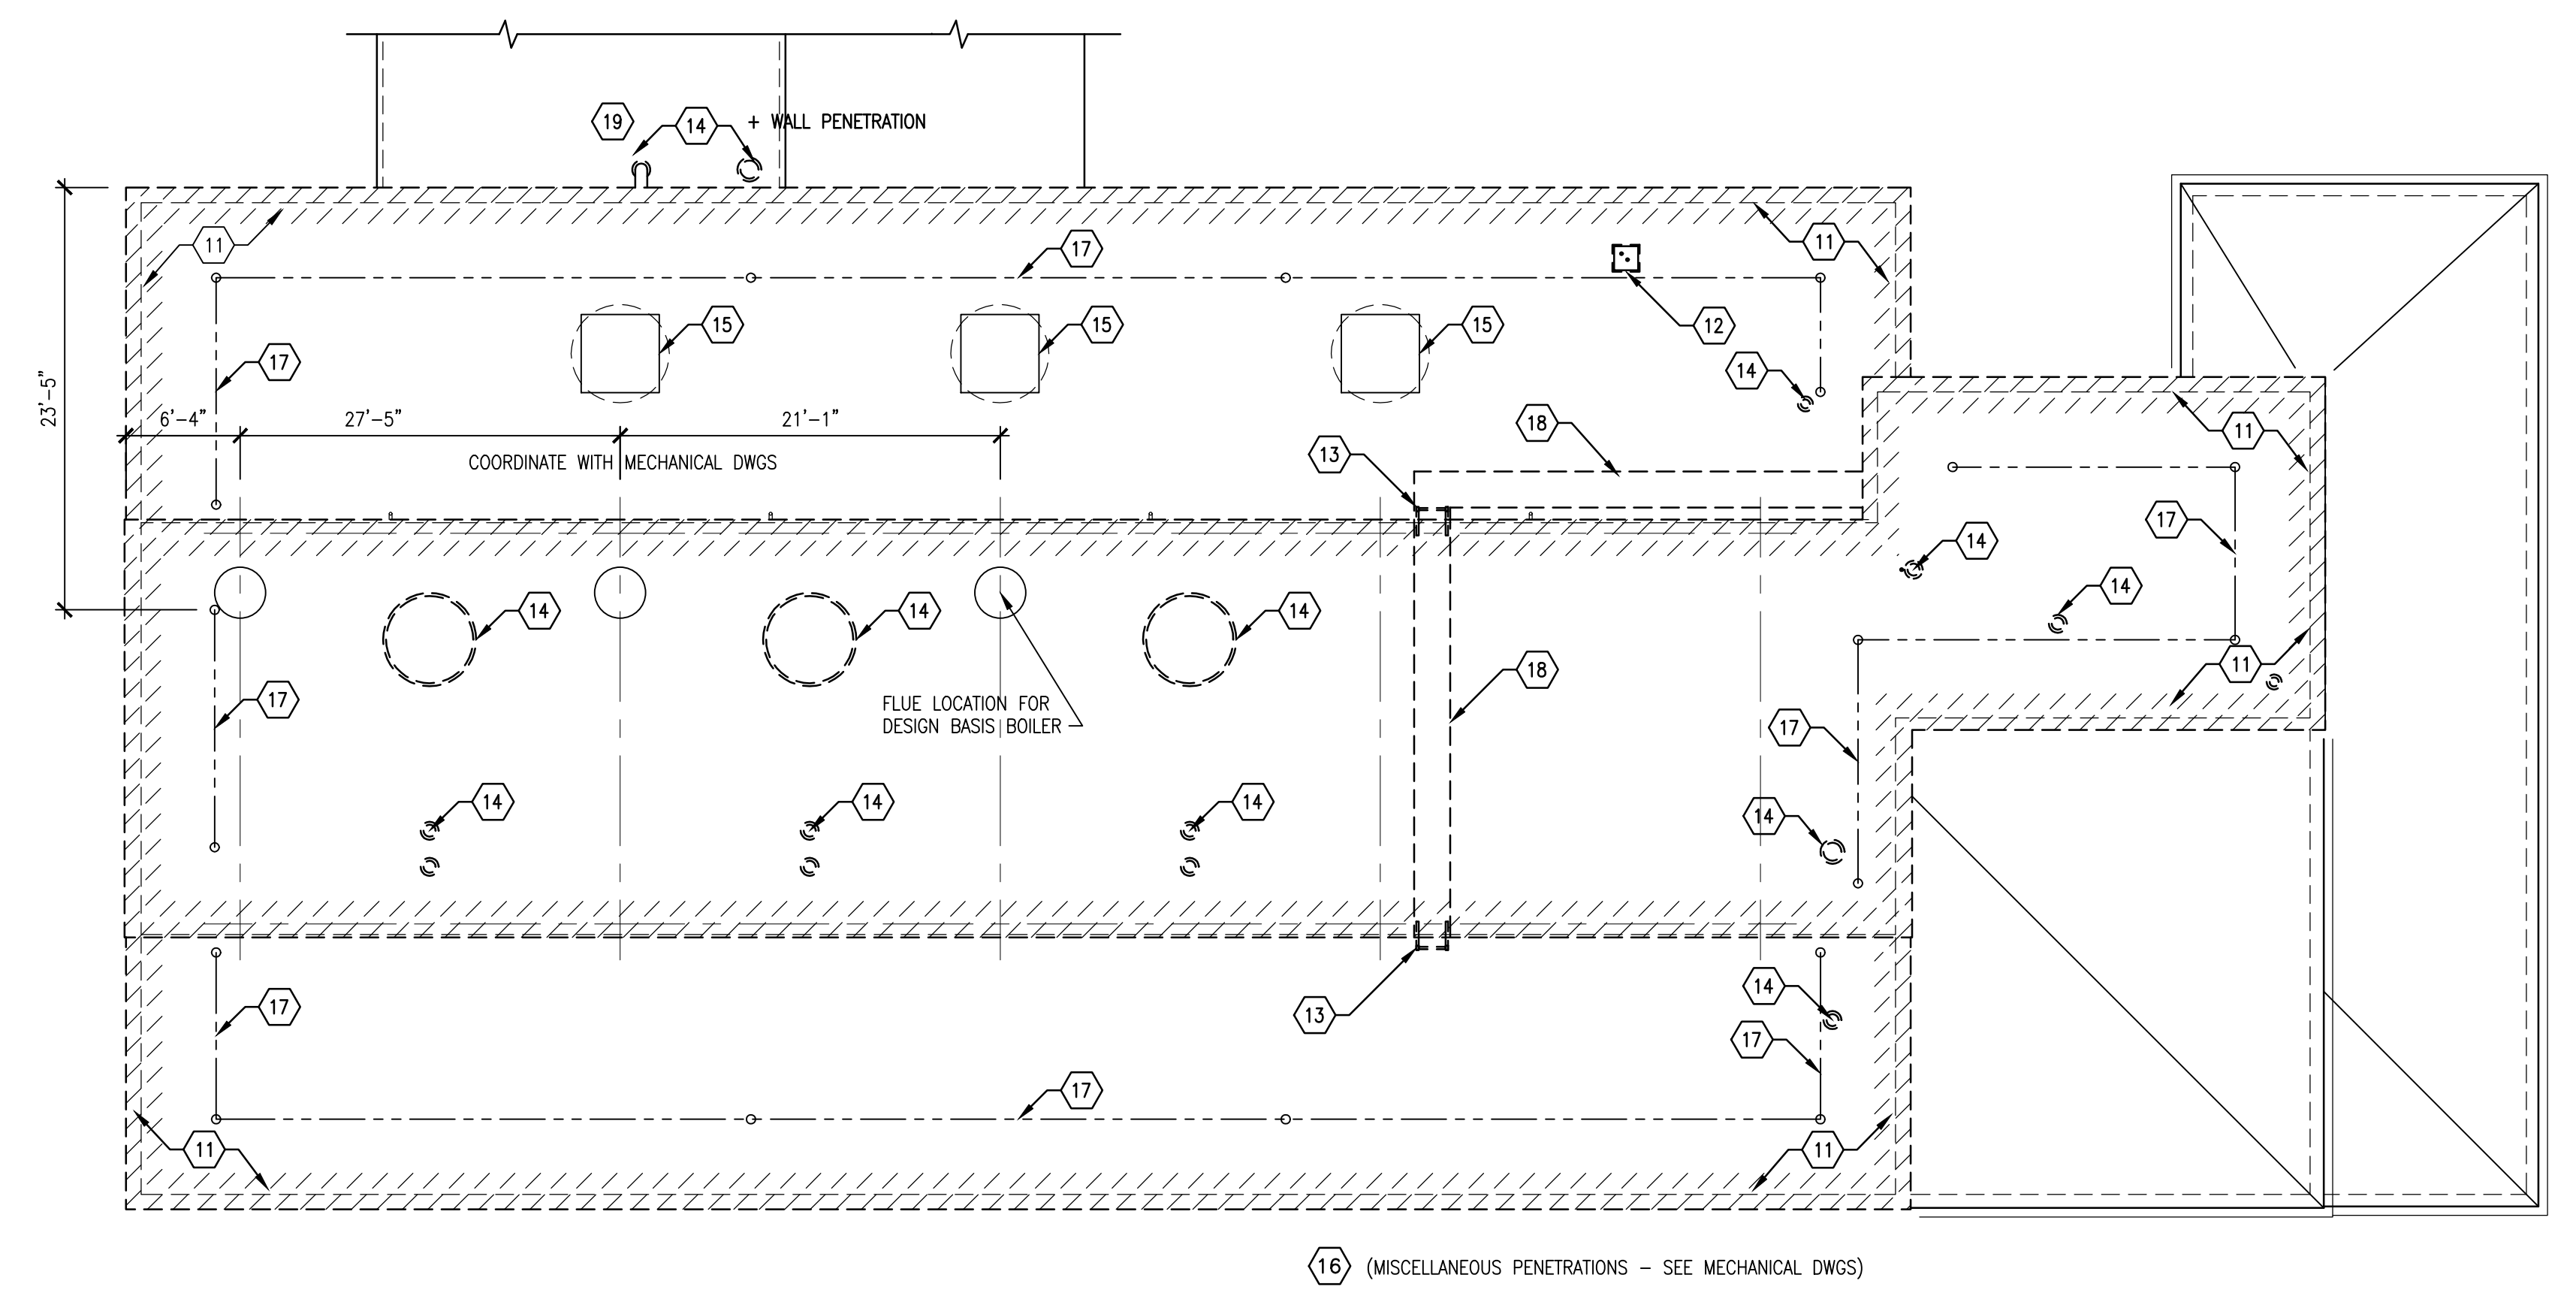

4 ROOF LEVEL DEMOLITION PLAN  
1/8" = 1'-0"  
EXISTING ROOF DECK: GYP- CONCRETE PLANK. REMOVE PLANK IN WHOLE PIECES FOR PENETRATIONS GREATER THAN 4" DIAMETER.  
REPLACE DECK WITH METAL DECK, MECHANICALLY ATTACHED (WR 1.5-20) INSULATED WITH R-22 INSULATION (OR GREATER)

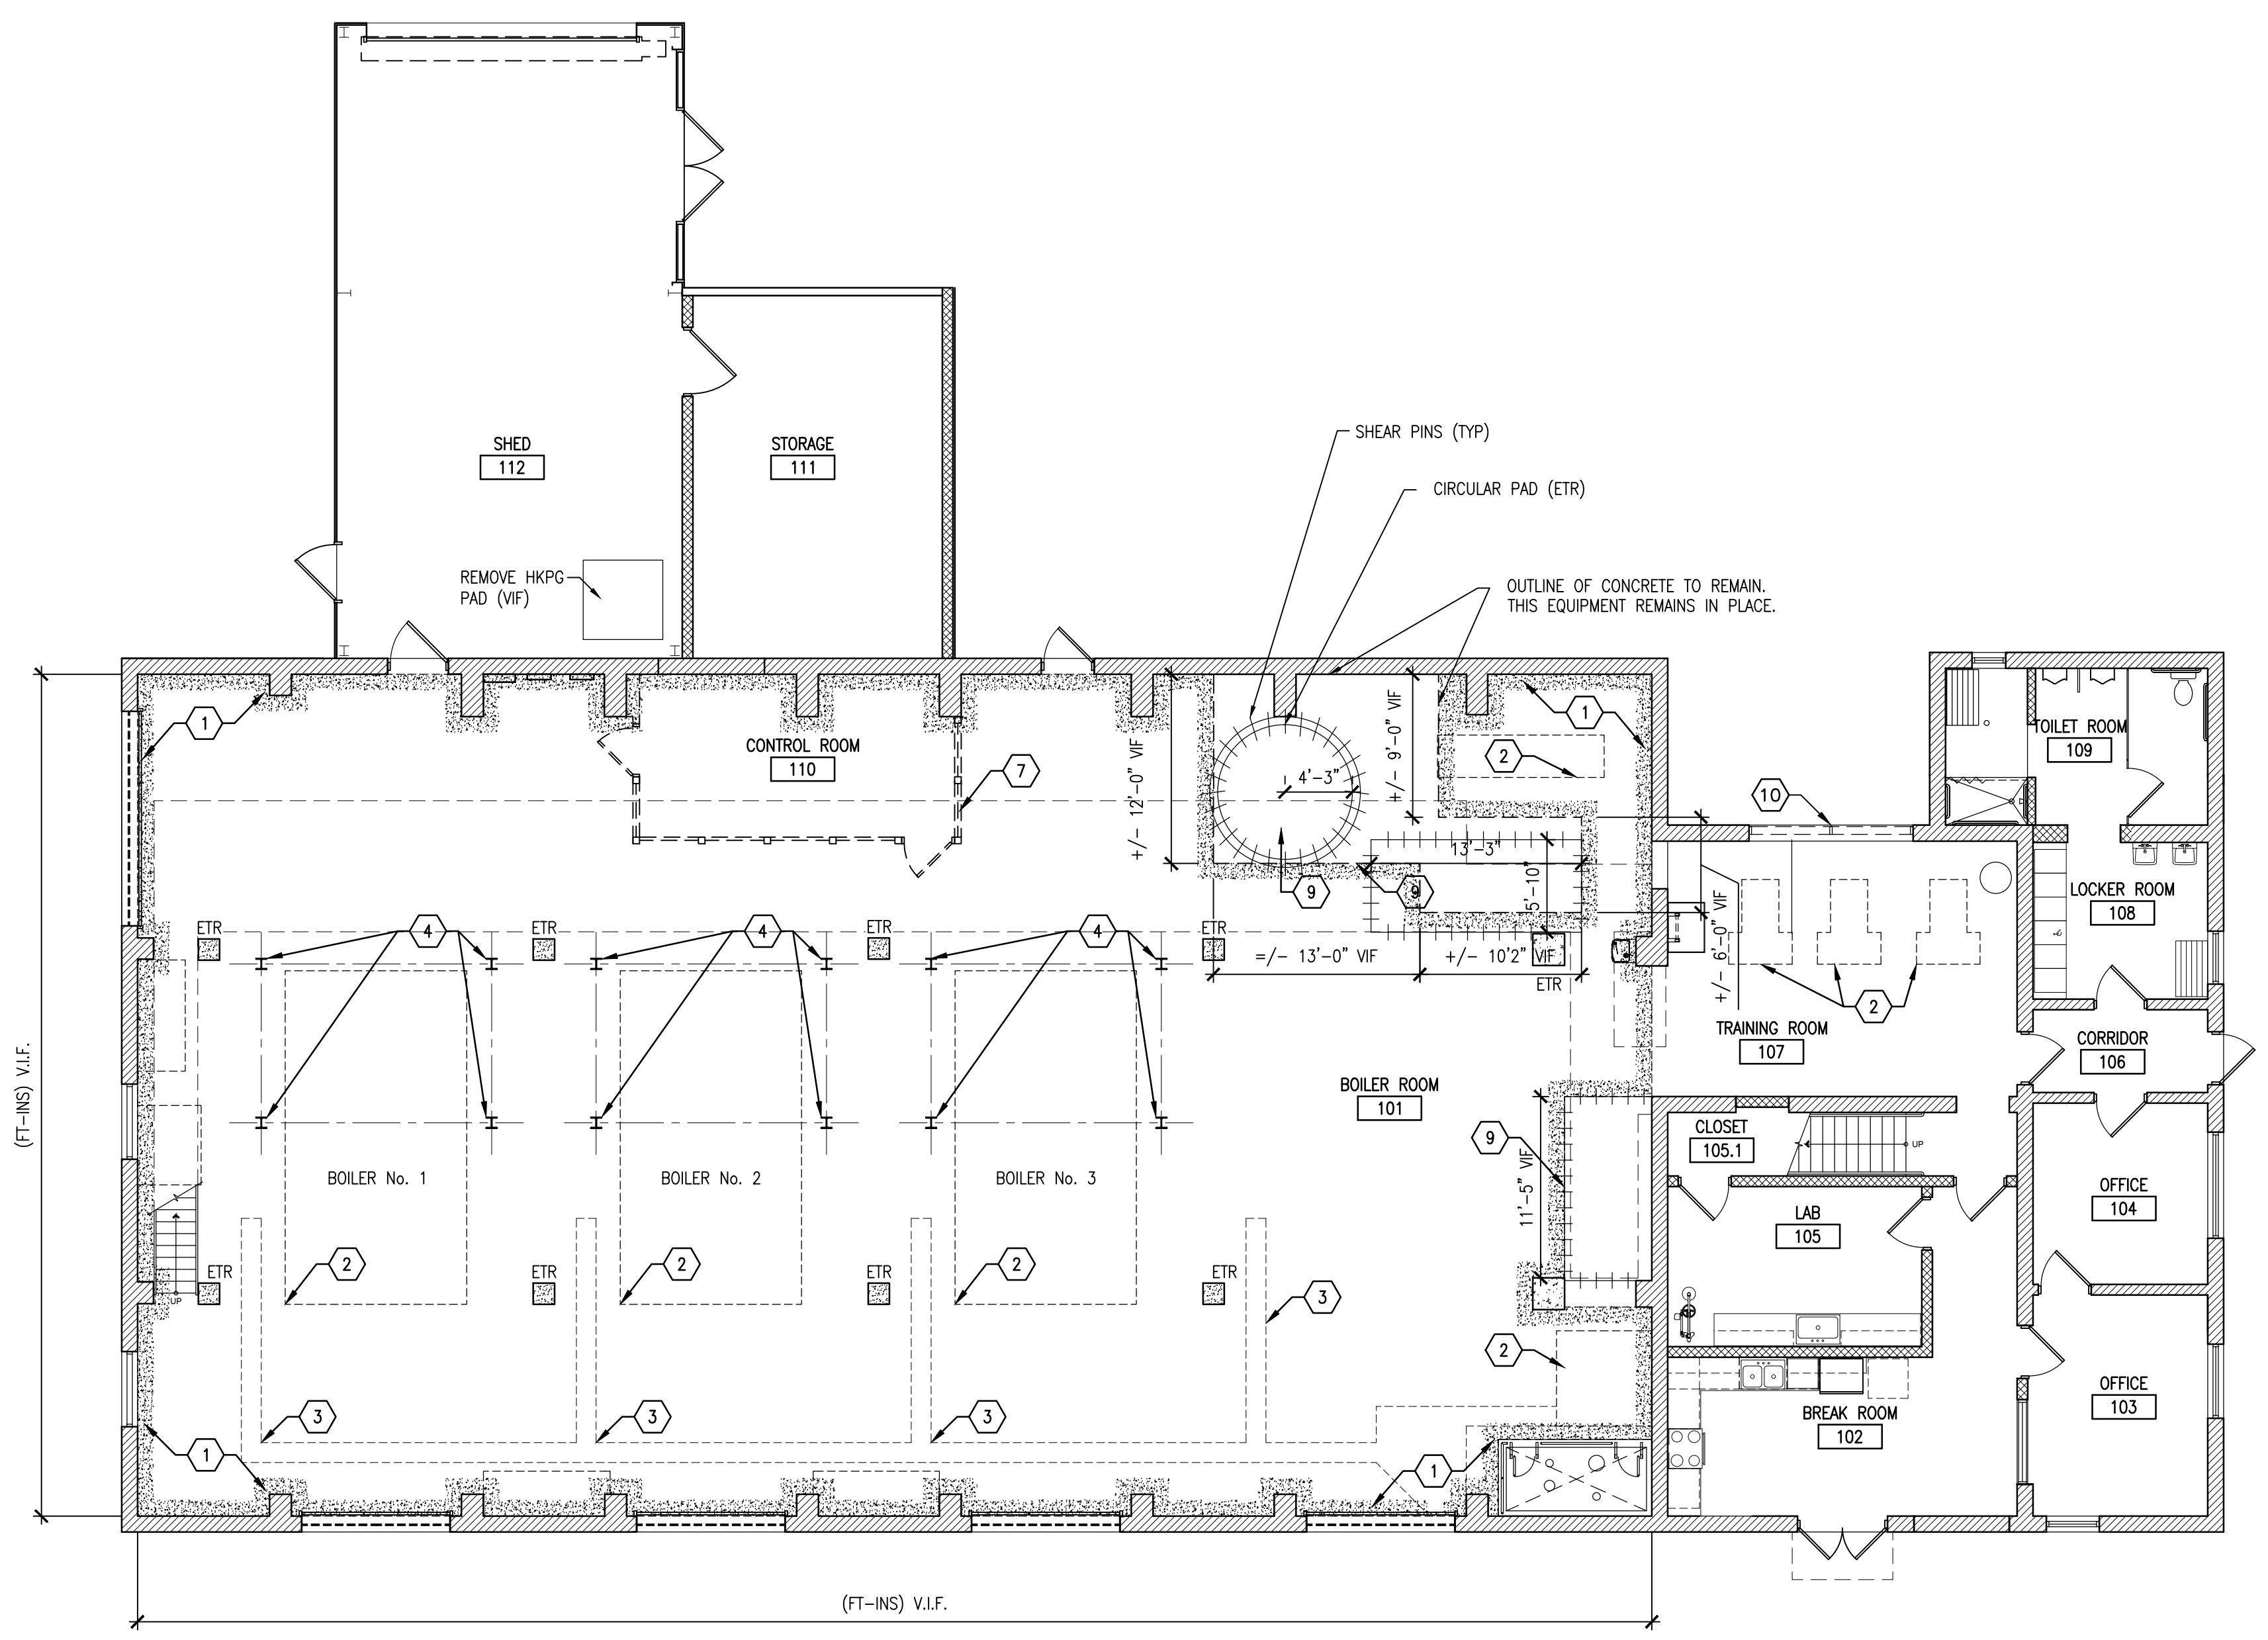

1 GROUND FLOOR DEMOLITION PLAN  
1/8" = 1'-0"

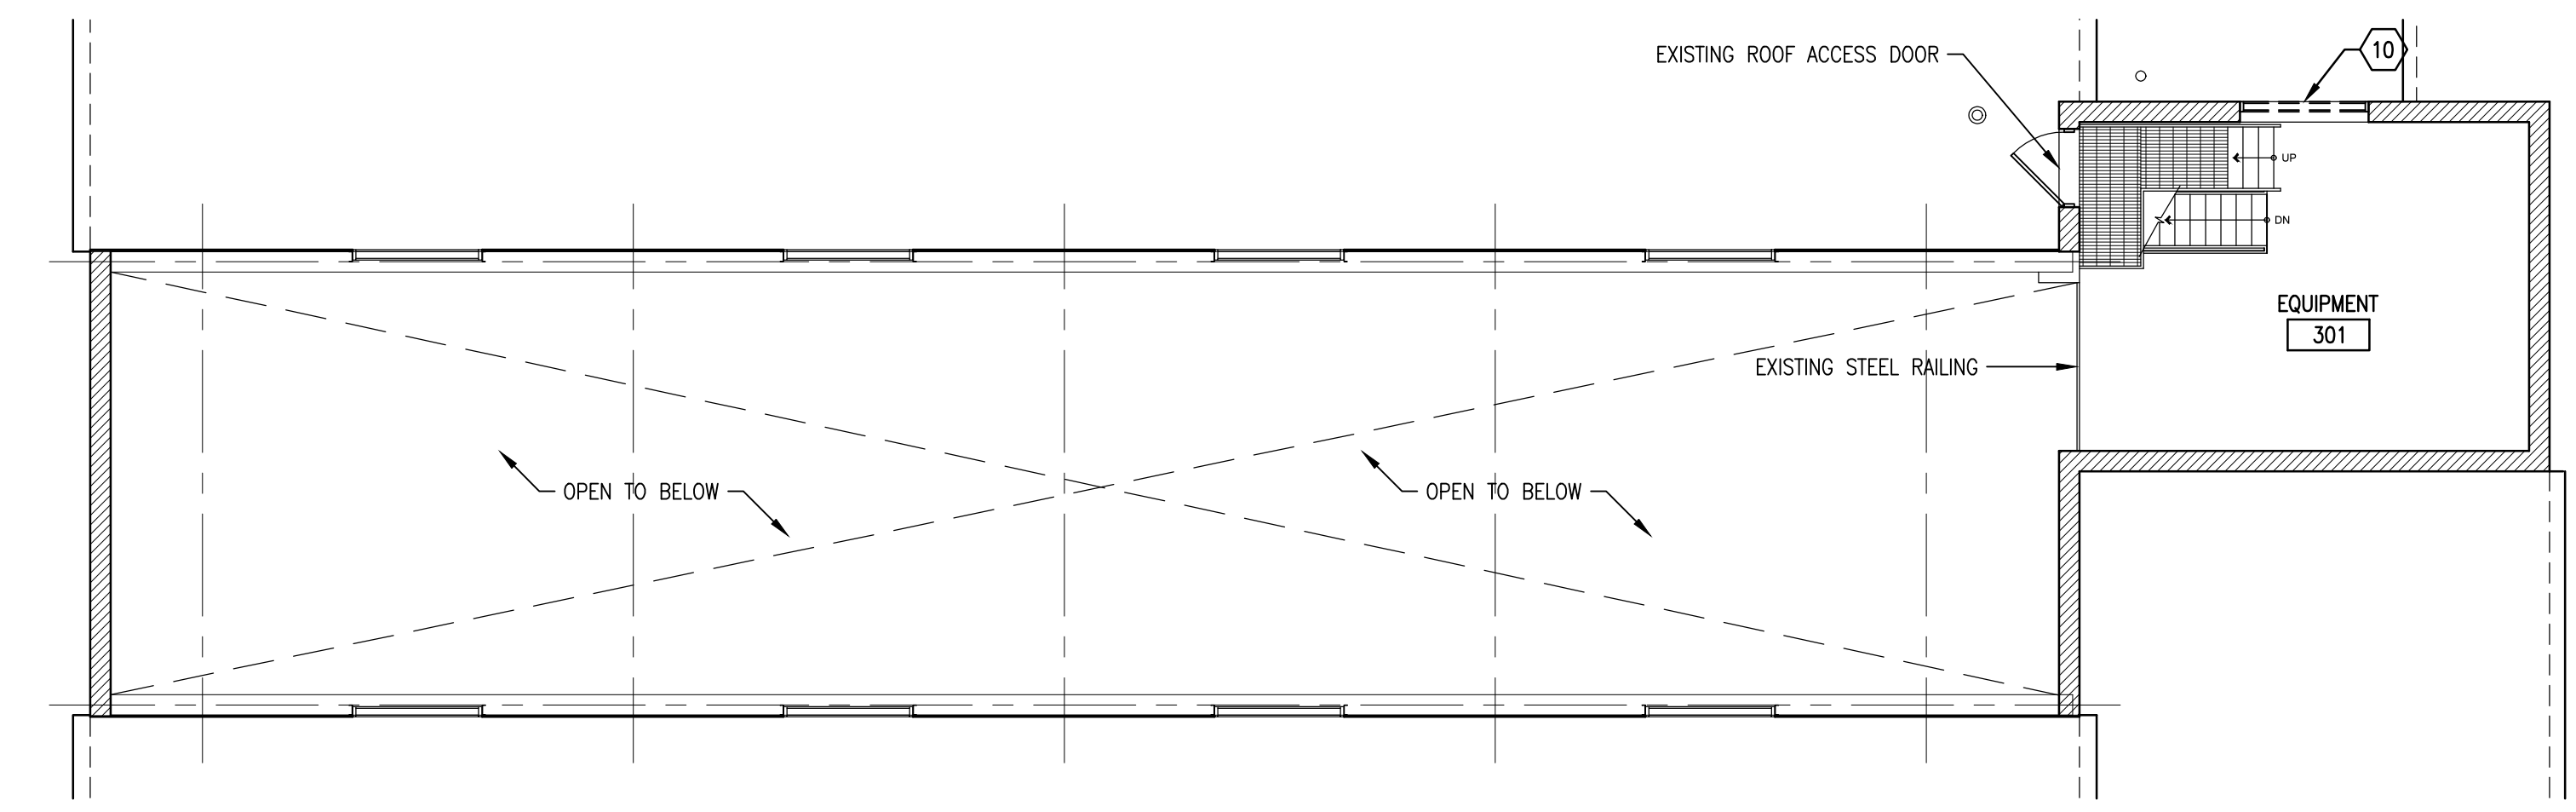

3 THIRD FLOOR/CLERESTORY DEMOLITION PLAN  
1/8" = 1'-0"

- DEMOLITION NOTES:
- REMOVE EXISTING CONCRETE SLAB THROUGHOUT BOILER ROOM. EXCEPT WHERE NOTED OTHERWISE
  - REMOVE EXISTING RAISED CONCRETE PAD.
  - REMOVE EXISTING CONCRETE TRENCH.
  - REMOVE EXISTING BOILER PLATFORM INCLUDING STEEL POSTS, BEAMS, AND RAILINGS. REMOVE TOP OF PIER DOWN TO 10" BELOW FINISHED FLOOR.
  - REMOVE EXISTING VALVE ACCESS PLATFORM INCLUDING STEEL SUPPORTS, RAILINGS, AND LADDER.
  - REMOVE EXISTING RAILING.
  - REMOVE EXISTING CONTROL ROOM.
  - PROVIDE SUPPORT FOR EXISTING STAIR PRIOR TO REMOVAL OF BOILER #1 PLATFORM. SEE STRUCTURAL.
  - EXISTING EQUIPMENT PAD TO REMAIN. PROVIDE REBAR SHEAR PINS AT 2'-0" O.C., #6, TO TIE THE CONCRETE SLAB TO EXISTING. SHEAR PINS SHALL EXTEND MIN 6" INTO CONCRETE. USE GROUT TO SECURE INTO EXISTING CONCRETE.
  - REMOVE EXISTING METAL LOUVER
  - REMOVE EXISTING ROOFING TO DECK, INCLUDING BALLAST, MEMBRANE, INSULATION, BLOCKING, FASCIAE, TRIM, AND FLASHING. DEPOSIT BALLAST ON SITE AT OWNER'S DIRECTION.
  - REMOVE EXISTING STEAM WHISTLE AND ASSOCIATED PITCH POCKET.
  - REMOVE EXISTING ROOF METAL LADDERS AND STORE FOR RE-INSTALLATION FOLLOWING ROOF ALTERATIONS.
  - EXISTING ROOF PIPE PENETRATION TO BE REPAIRED.
  - EXISTING ROOF PENETRATION TO REMAIN.
  - CUT OPENING AS REQUIRED FOR PROPOSED ROOF PENETRATION - SEE MECHANICAL DRAWINGS.
  - EXISTING FALL PROTECTION CABLE SYSTEM TO REMAIN. REMOVE AND STORE CABLE TO PREVENT DAMAGE DURING DEMOLITION AND RE-ROOFING.
  - REMOVE PAVERS - PLACE IN STORAGE LOCATION AT OWNER'S DIRECTION.
  - REPAIR MASONRY WALL BY "TOOTHING" BRICKS INTO OPENING.
  - EXISTING SLAB THICKNESS VARIES. THICKNESS CAN BE 18" THICK. RAILROAD STEEL RAILS ARE KNOWN TO BE EMBEDDED.
  - PLUG ABANDONED PIPE.

ABBREVIATIONS:  
ETR EXISTING TO REMAIN

GENERAL NOTE:  
1. COORDINATE WITH MECHANICAL DRAWINGS

Revisions:		Date		CONSULTANTS:		ARCHITECT/ENGINEERS:		Drawing Title		Project Title		Project Number		Office of Construction and Facilities Management Department of Veterans Affairs	
								ARCHITECTURAL DEMOLITION PLANS		BOILER PLANT UPGRADE PHASE V		613-12-501			
								Approved: Project Director		Location		Building Number			
										VAMC MARTINSBURG, WV		320			
										Date		Drawing Number			
										10.22.13		320-AD101			
										Checked		Dwg.		9 of 44	









## KEY NOTES:

1. LOCATION, SIZE, AND CONFIGURATION OF ALL TRENCHES, EQUIPMENT SUPPORTS, AND PLATFORMS ARE PROVIDED FOR ESTIMATING AND BIDDING PURPOSES ONLY, AND APPLY ONLY TO THE BASIS-OF-DESIGN SYSTEMS AND EQUIPMENT. THE CONTRACTOR SHALL COORDINATE LOCATION, SIZE, AND CONFIGURATION OF ALL TRENCHES, EQUIPMENT SUPPORTS, AND PLATFORMS WITH THE SELECTED SYSTEMS AND EQUIPMENT.
2. EXISTING EQUIPMENT PAD TO REMAIN. PROVIDE SHEAR PINS TO NEW CONCRETE. OVER EXCAVATE 12"x18"W TO ENCASE INS. TURN DOWN W.W.F TO BE BLOW SHEAR PIN.
3. CONCRETE EQUIPMENT PAD, SEE STRUCTURAL DRAWINGS. COORDINATE WITH MECHANICAL DWGS, LOCATION WILL VARY.
4. PIPING TRENCH, COORDINATE WITH MECHANICAL, PLUMBING & STRUCTURAL DRAWINGS. USE S10 SEALANT IN ALL TRENCH JOINTS. MINIMUM TRENCH INVERT: -1.5 FEET
5. STEEL PLATFORM SUPPORT, SEE STRUCTURAL DRAWINGS.
6. INFILL EXISTING OPENING WITH MASONRY TO MATCH EXISTING ADJACENT CONSTRUCTION; PAINT.
7. INFILL EXISTING OPENING WITH BRICK TO MATCH EXISTING.
8. PROVIDE 4"x8" DRY ERASE BOARD W/ TACK STRIP.
9. BOILER PLATFORM AND STAIR, SEE STRUCTURAL.
10. STEEL LADDER TO GROUND FLOOR.
11. PROVIDE GUARD RAIL AT 42" ABOVE WALKING SURFACE WITH 4" TOEPLATE AND MID-RAIL, TYP.

## SYMBOLS:

CMU

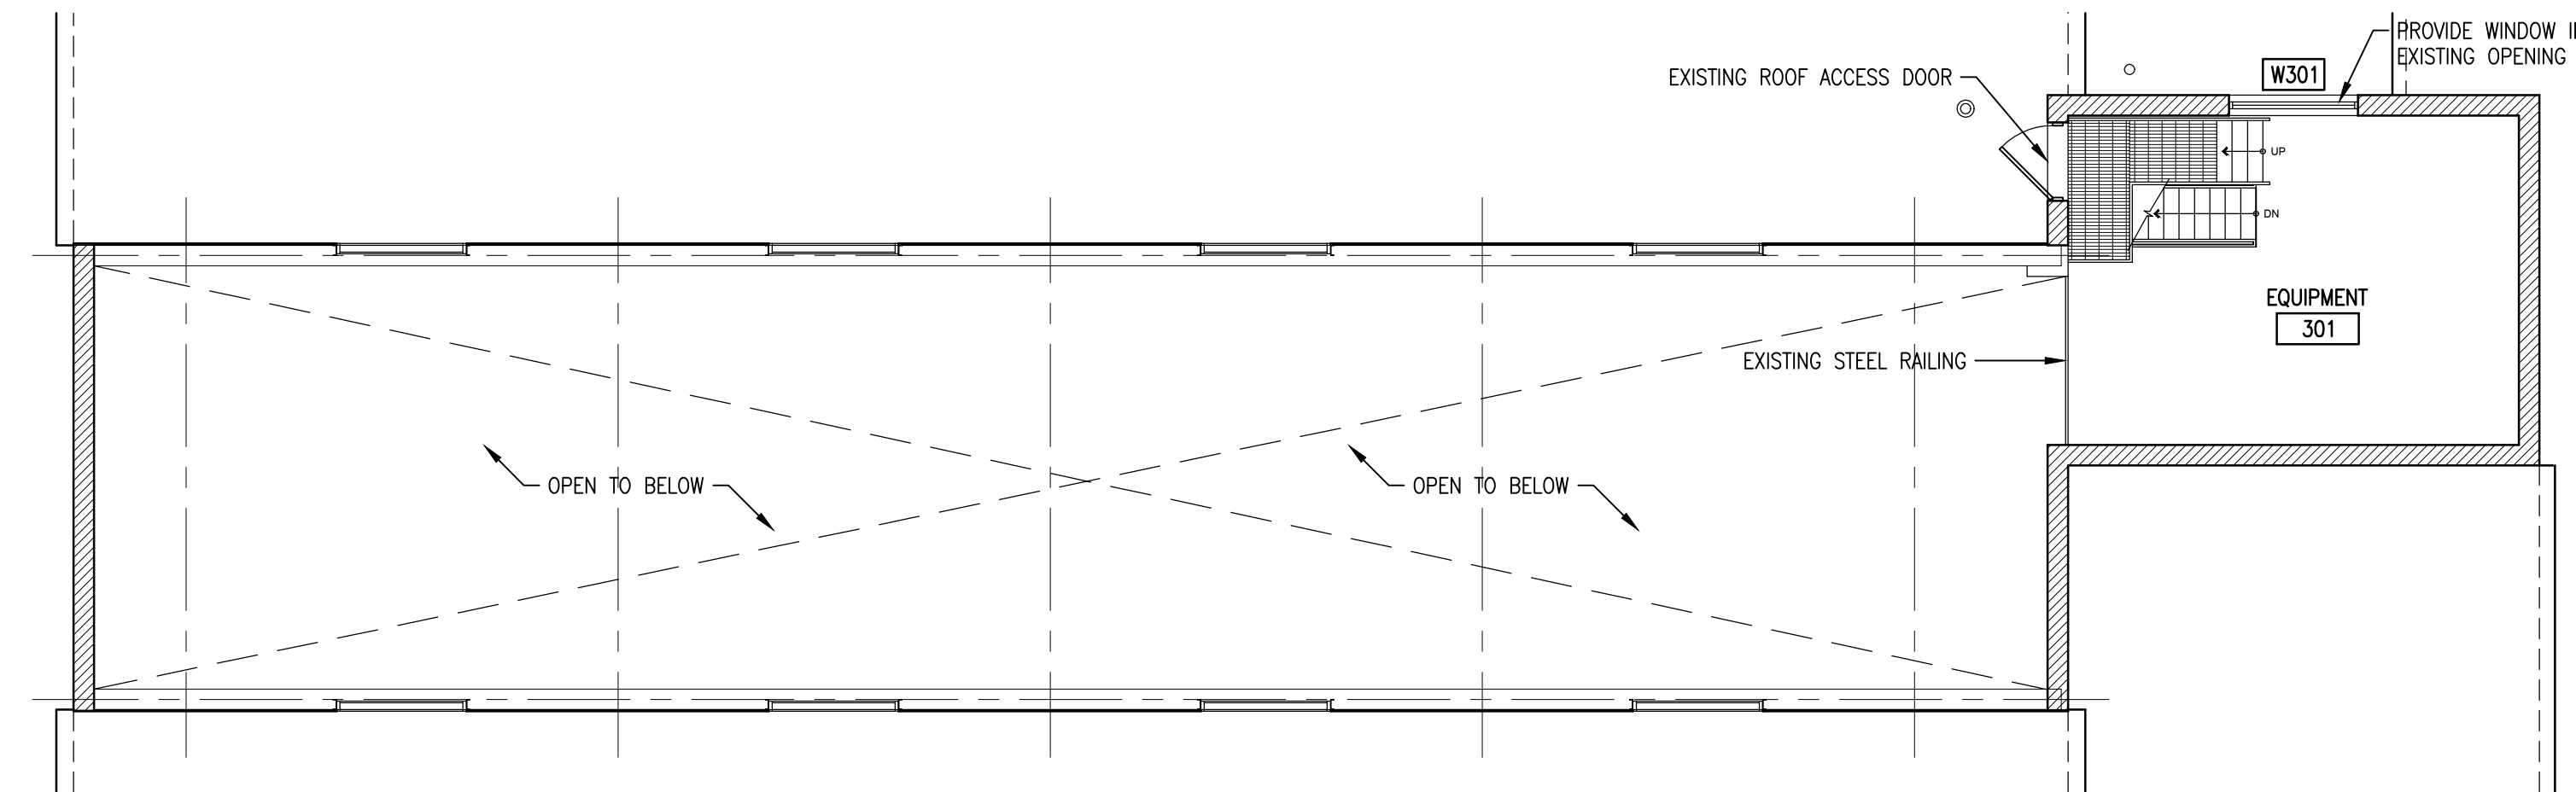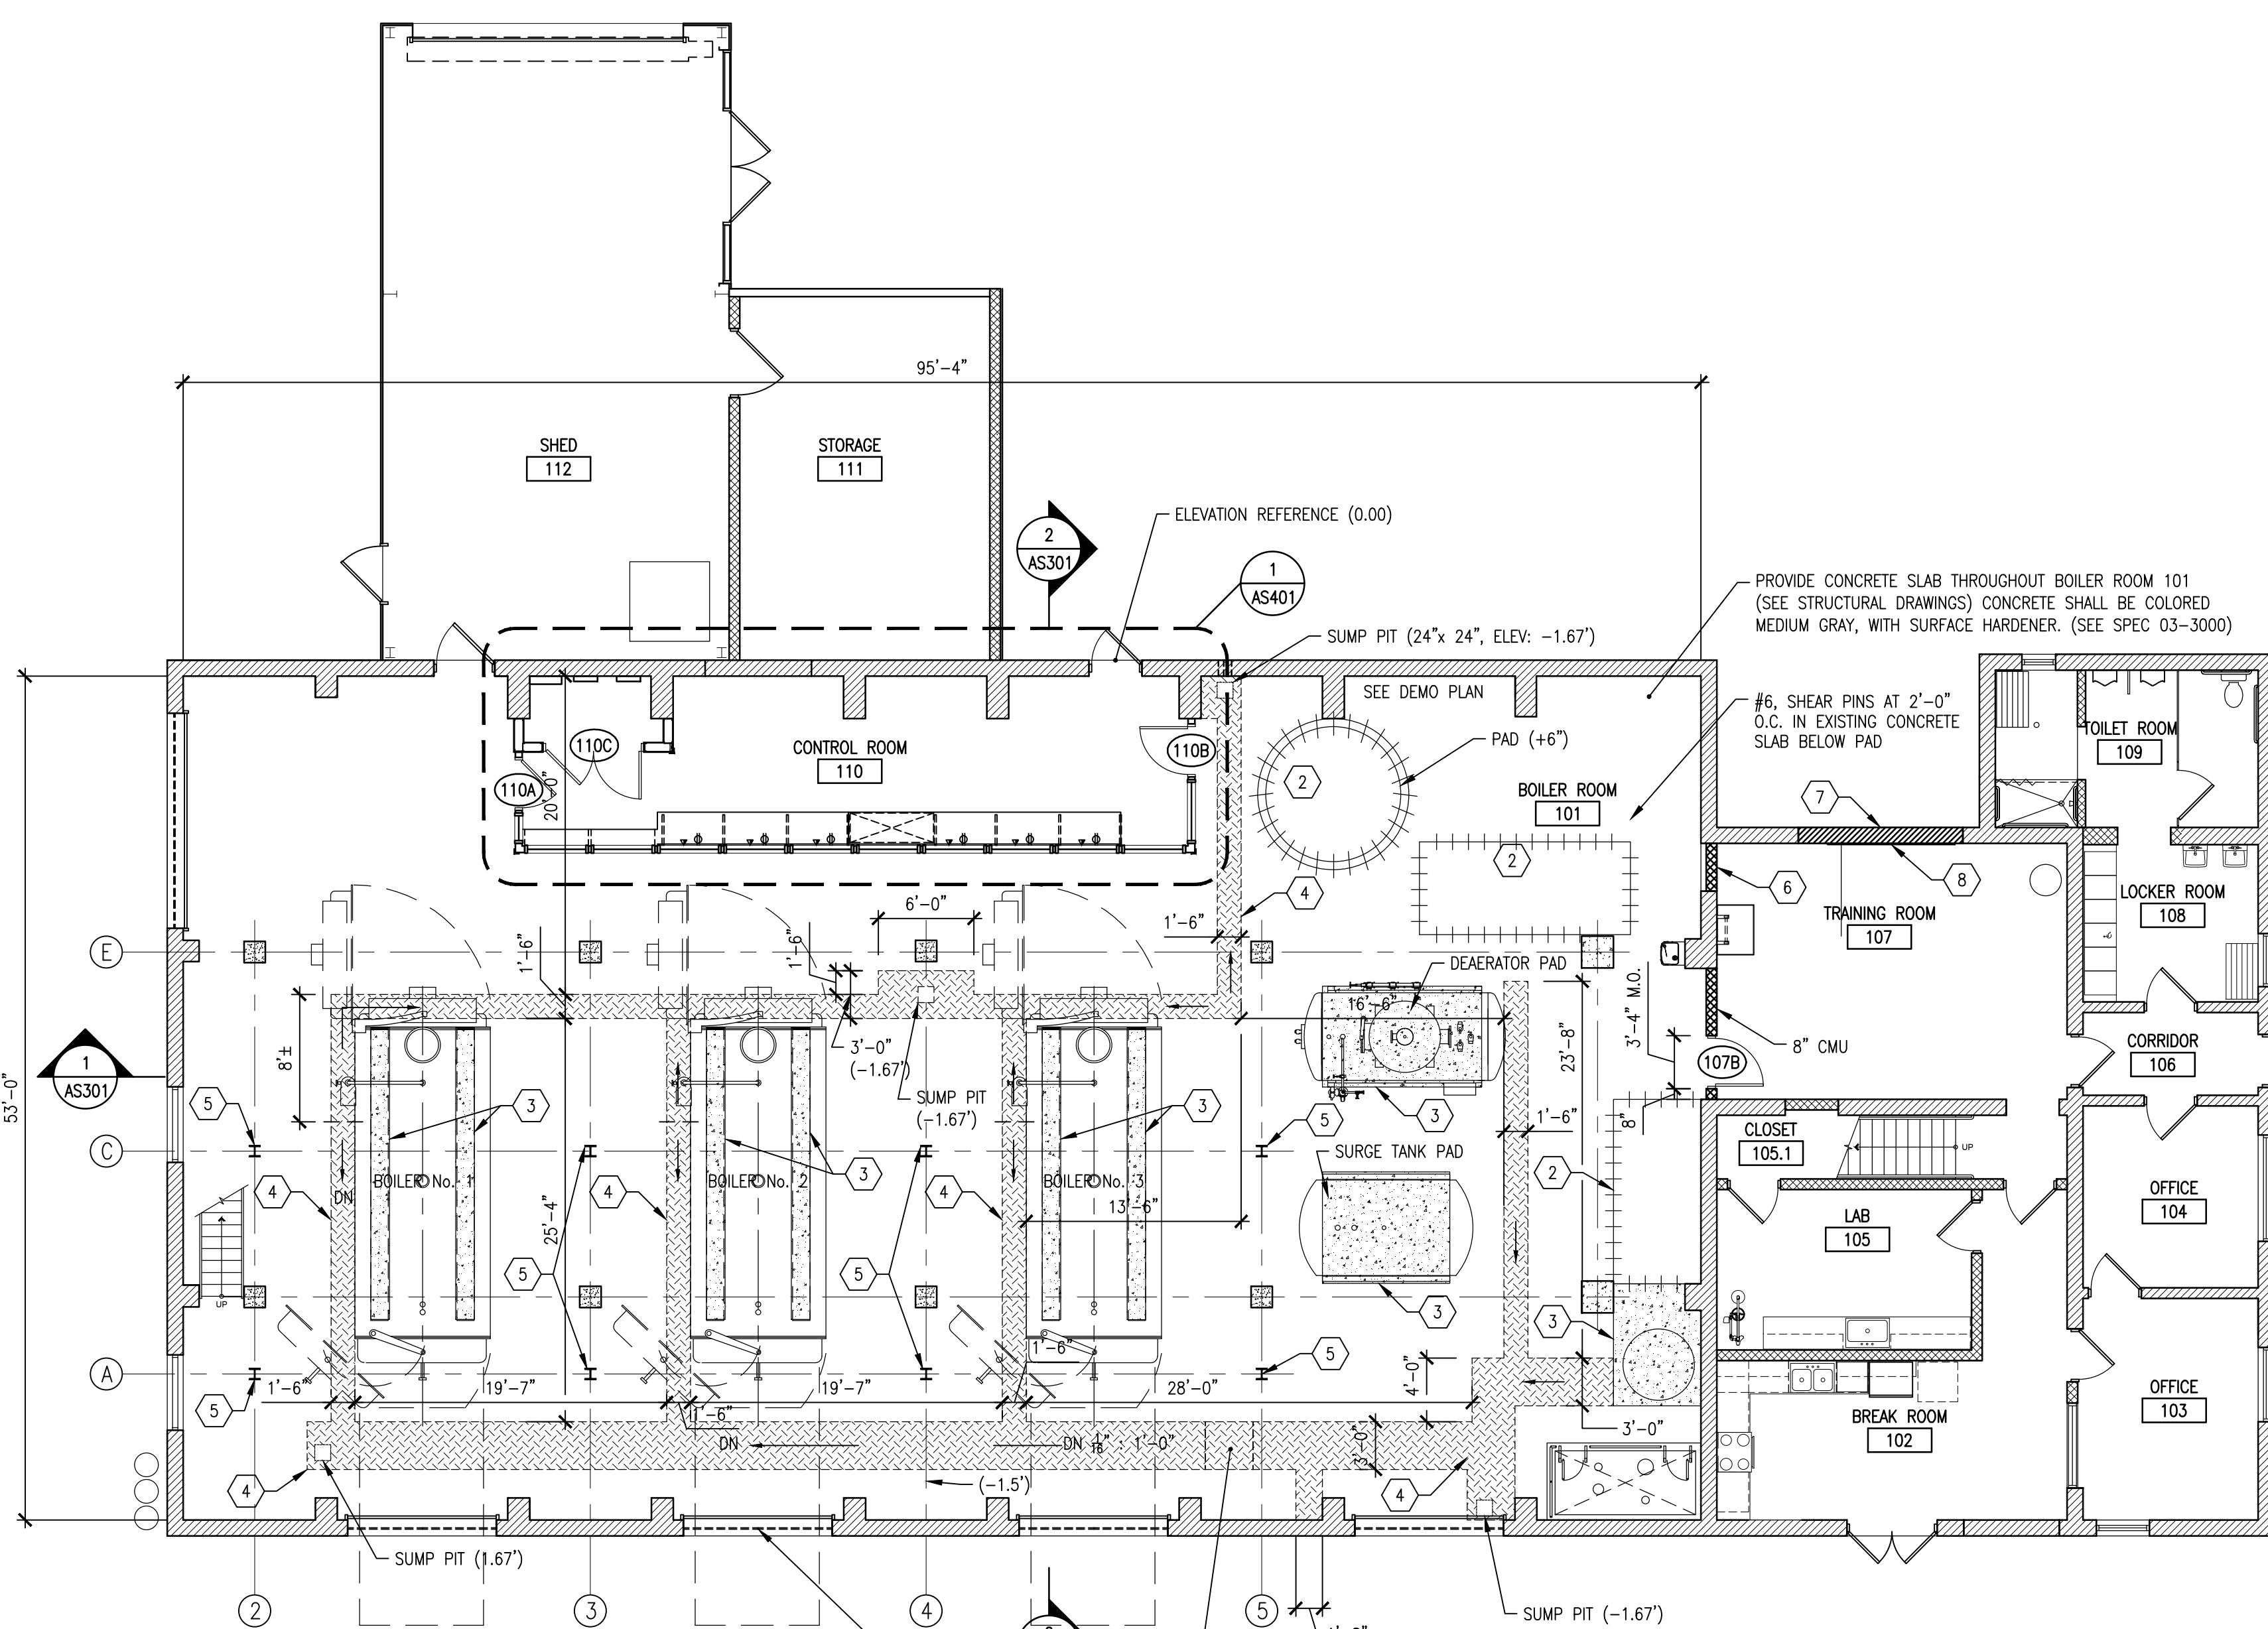3 THIRD FLOOR AND CLERESTORY PLAN  
1/8" = 1'-0"1 GROUND FLOOR PLAN  
1/8" = 1'-0"

NOTES: 1. — INDICATES BOTTOM OF TRENCH SLOPES TO SUMP PIT.

2. COVERS SHALL BE 3" OR LESS AND MAX 200 POUNDS WEIGHT.


3. PROVIDE SURFACE HARDENER.

4. FLATNESS COMPLIES WITH SPEC SECTION 3.13 b, 11b. COMPLIANCE AT DISCRETION OF COTR. MAY INCLUDE SLAB REMOVAL, GRINDING OR PLANING. FLATNESS AND LEVELNESS ARE CRITICAL FOR USE OF MOBILE PLATFORMS AND TO PREVENT PUDDLING.

5. PROVIDE COLORANT IN CONCRETE MIX. COR WILL APPROVE COLOR. COLOR RANGE: MEDIUM TO LIGHT GRAY.

6. COMPACT SUBGRADE AND SUB-BASE (6" ASHTO #57) TO PROVIDE MINIMUM 2500 PSF BEARING.

7. SUMP PIT SHALL BE 8" BELOW TRENCH (ELEVATIONS SHOWN ARE TRENCH ELEVATIONS)

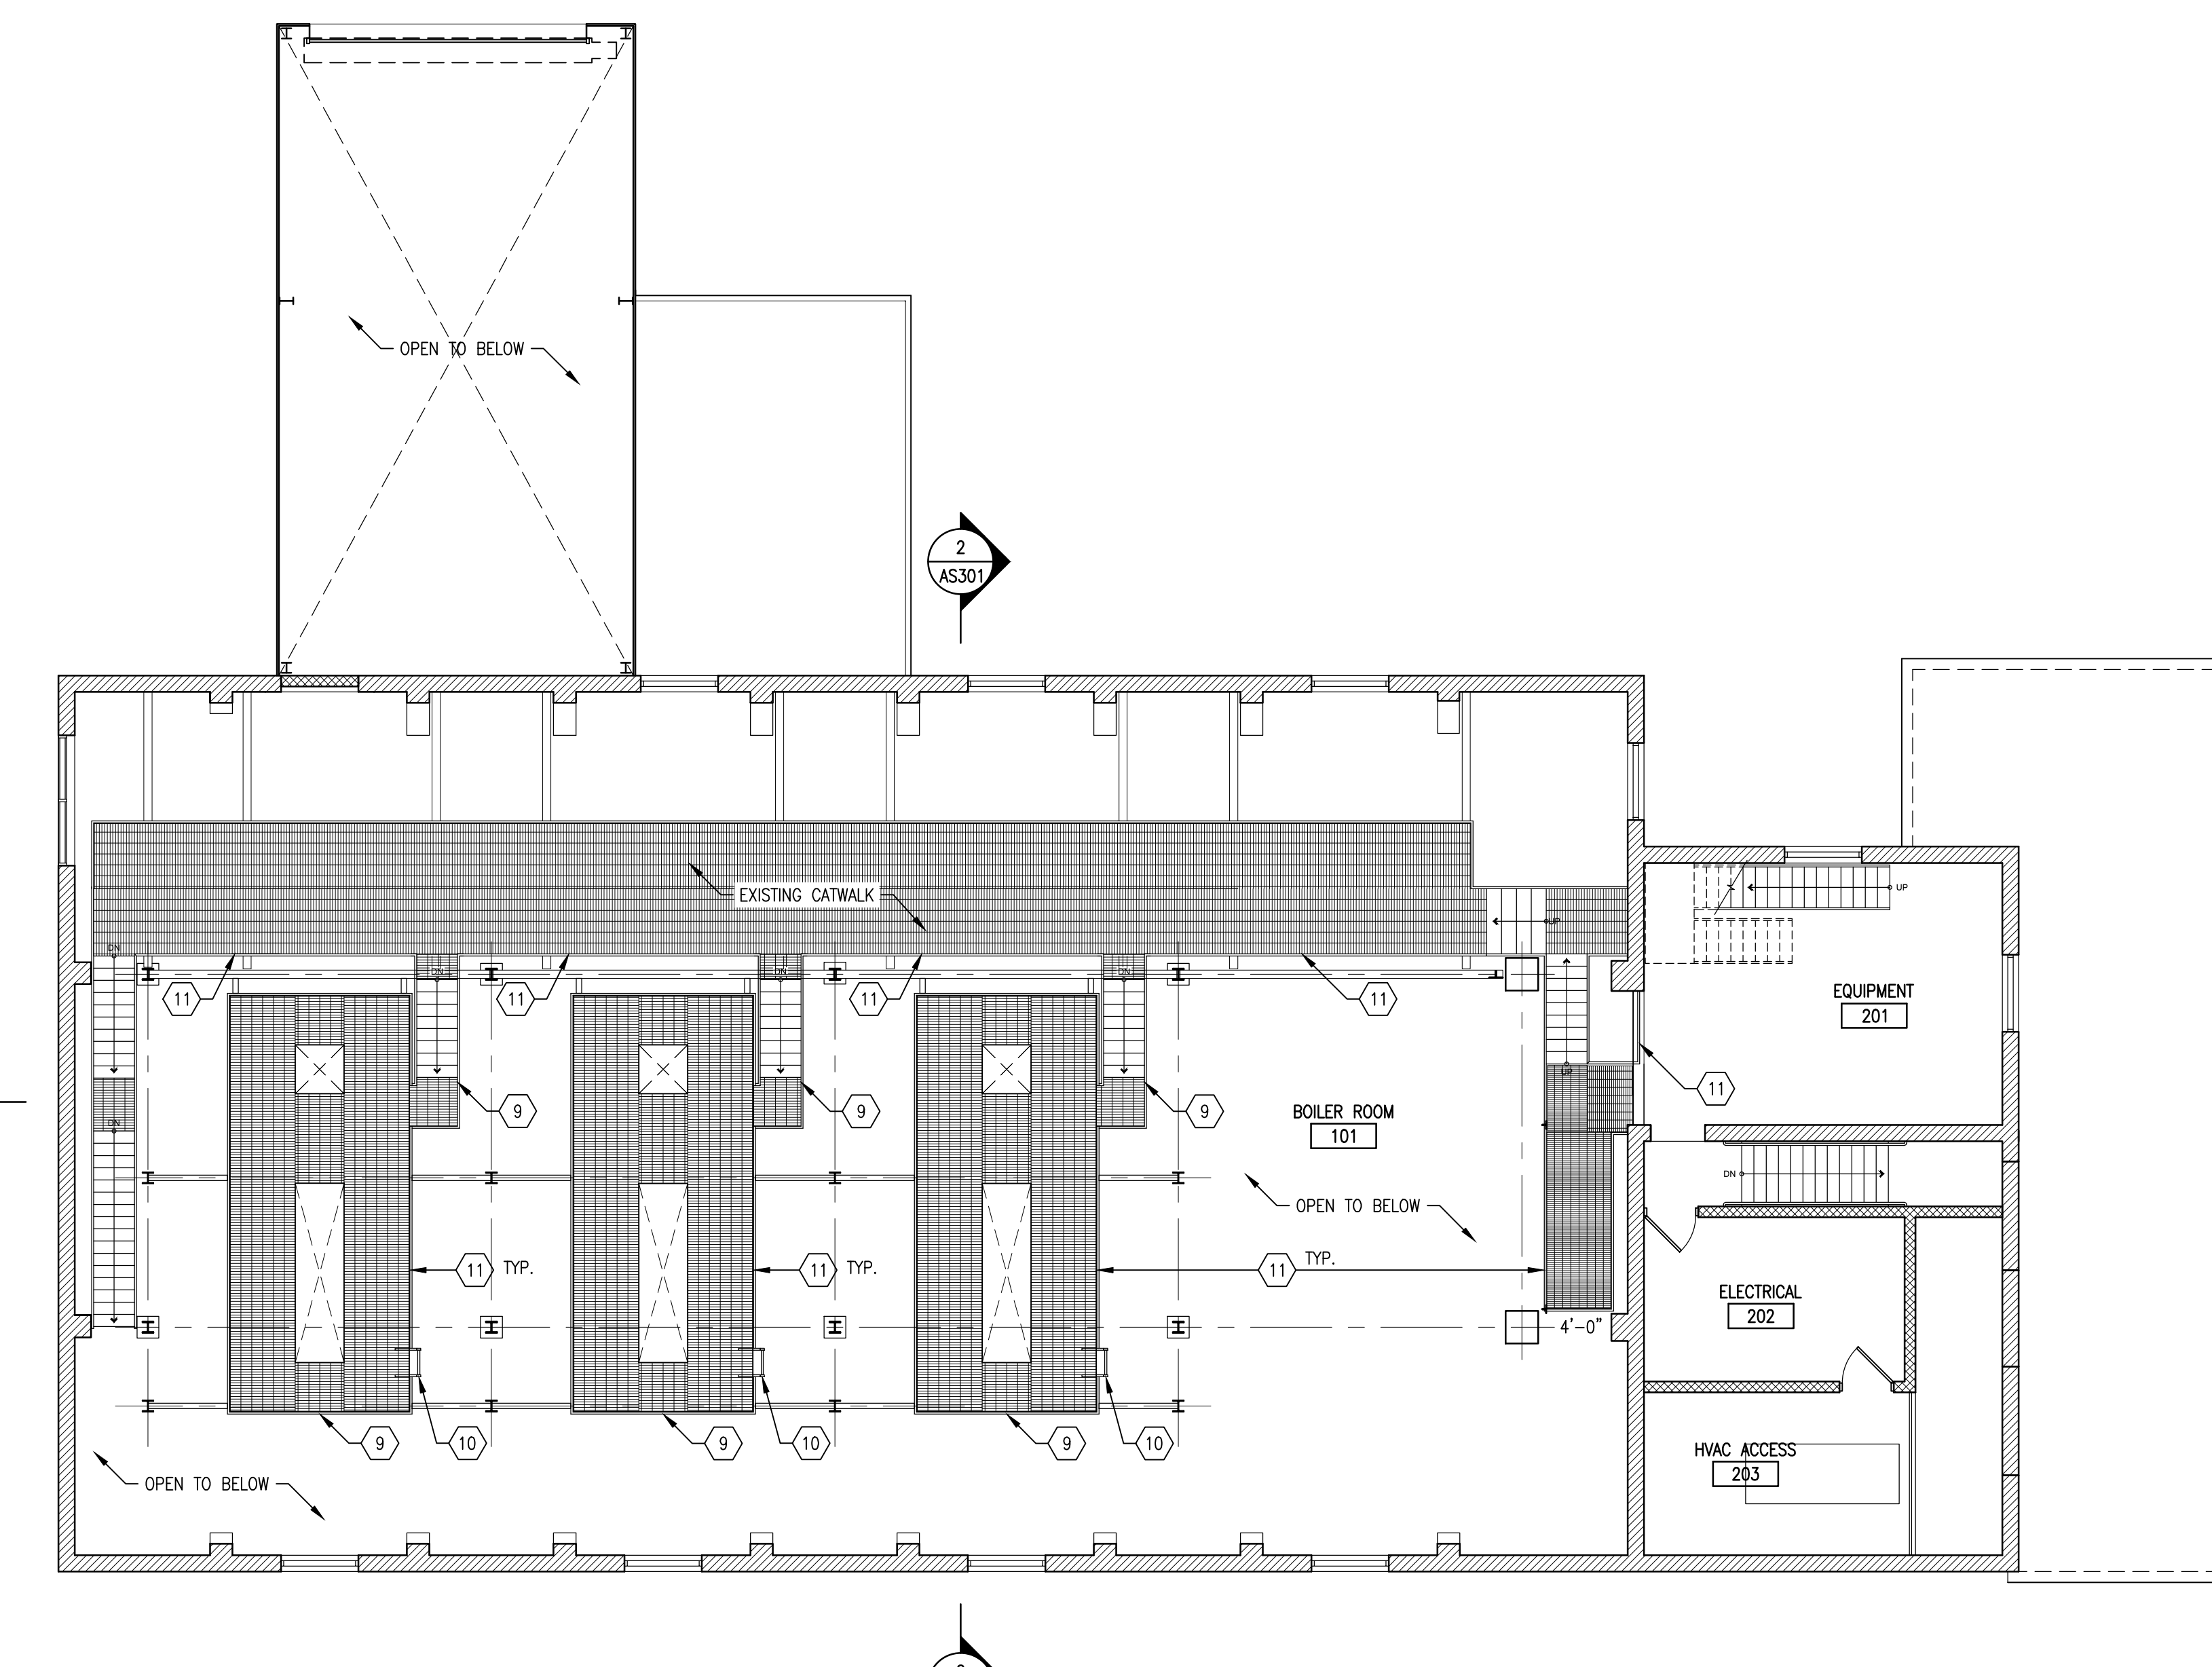PROVIDE DIAMOND PLATE THRESHOLDS  
(SEE 2/AS301), (TYP 4 OVERHEAD OPENINGS)DIAMOND PLATE COVERS W/ FLUSH  
DROP HANDLES (TYP.). ELEVATIONS SHOWN ARE BELOW TOP PLATE/TOP OF TRENCH2 SECOND FLOOR PLAN  
1/8" = 1'-0"

## CONSULTANTS:

## ARCHITECT/ENGINEERS:

SAA architects

600 North Hartley Street, Suite 150  
T 717.843.3200 F 717.699.0205York, PA 17404  
www.saaarchitects.com

Drawing Title

FLOOR PLANS

Approved: Project Director

Project Title

BOILER PLANT UPGRADE  
PHASE VLocation  
VAMC MARTINSBURG, WVDate  
10.22.13

Checked

Drawn

Project Number

613-12-501

Building Number

320

Drawing Number

320-AS101


Dwg. 10 of 44

Office of  
Construction and Facilities  
ManagementDepartment of  
Veterans Affairs







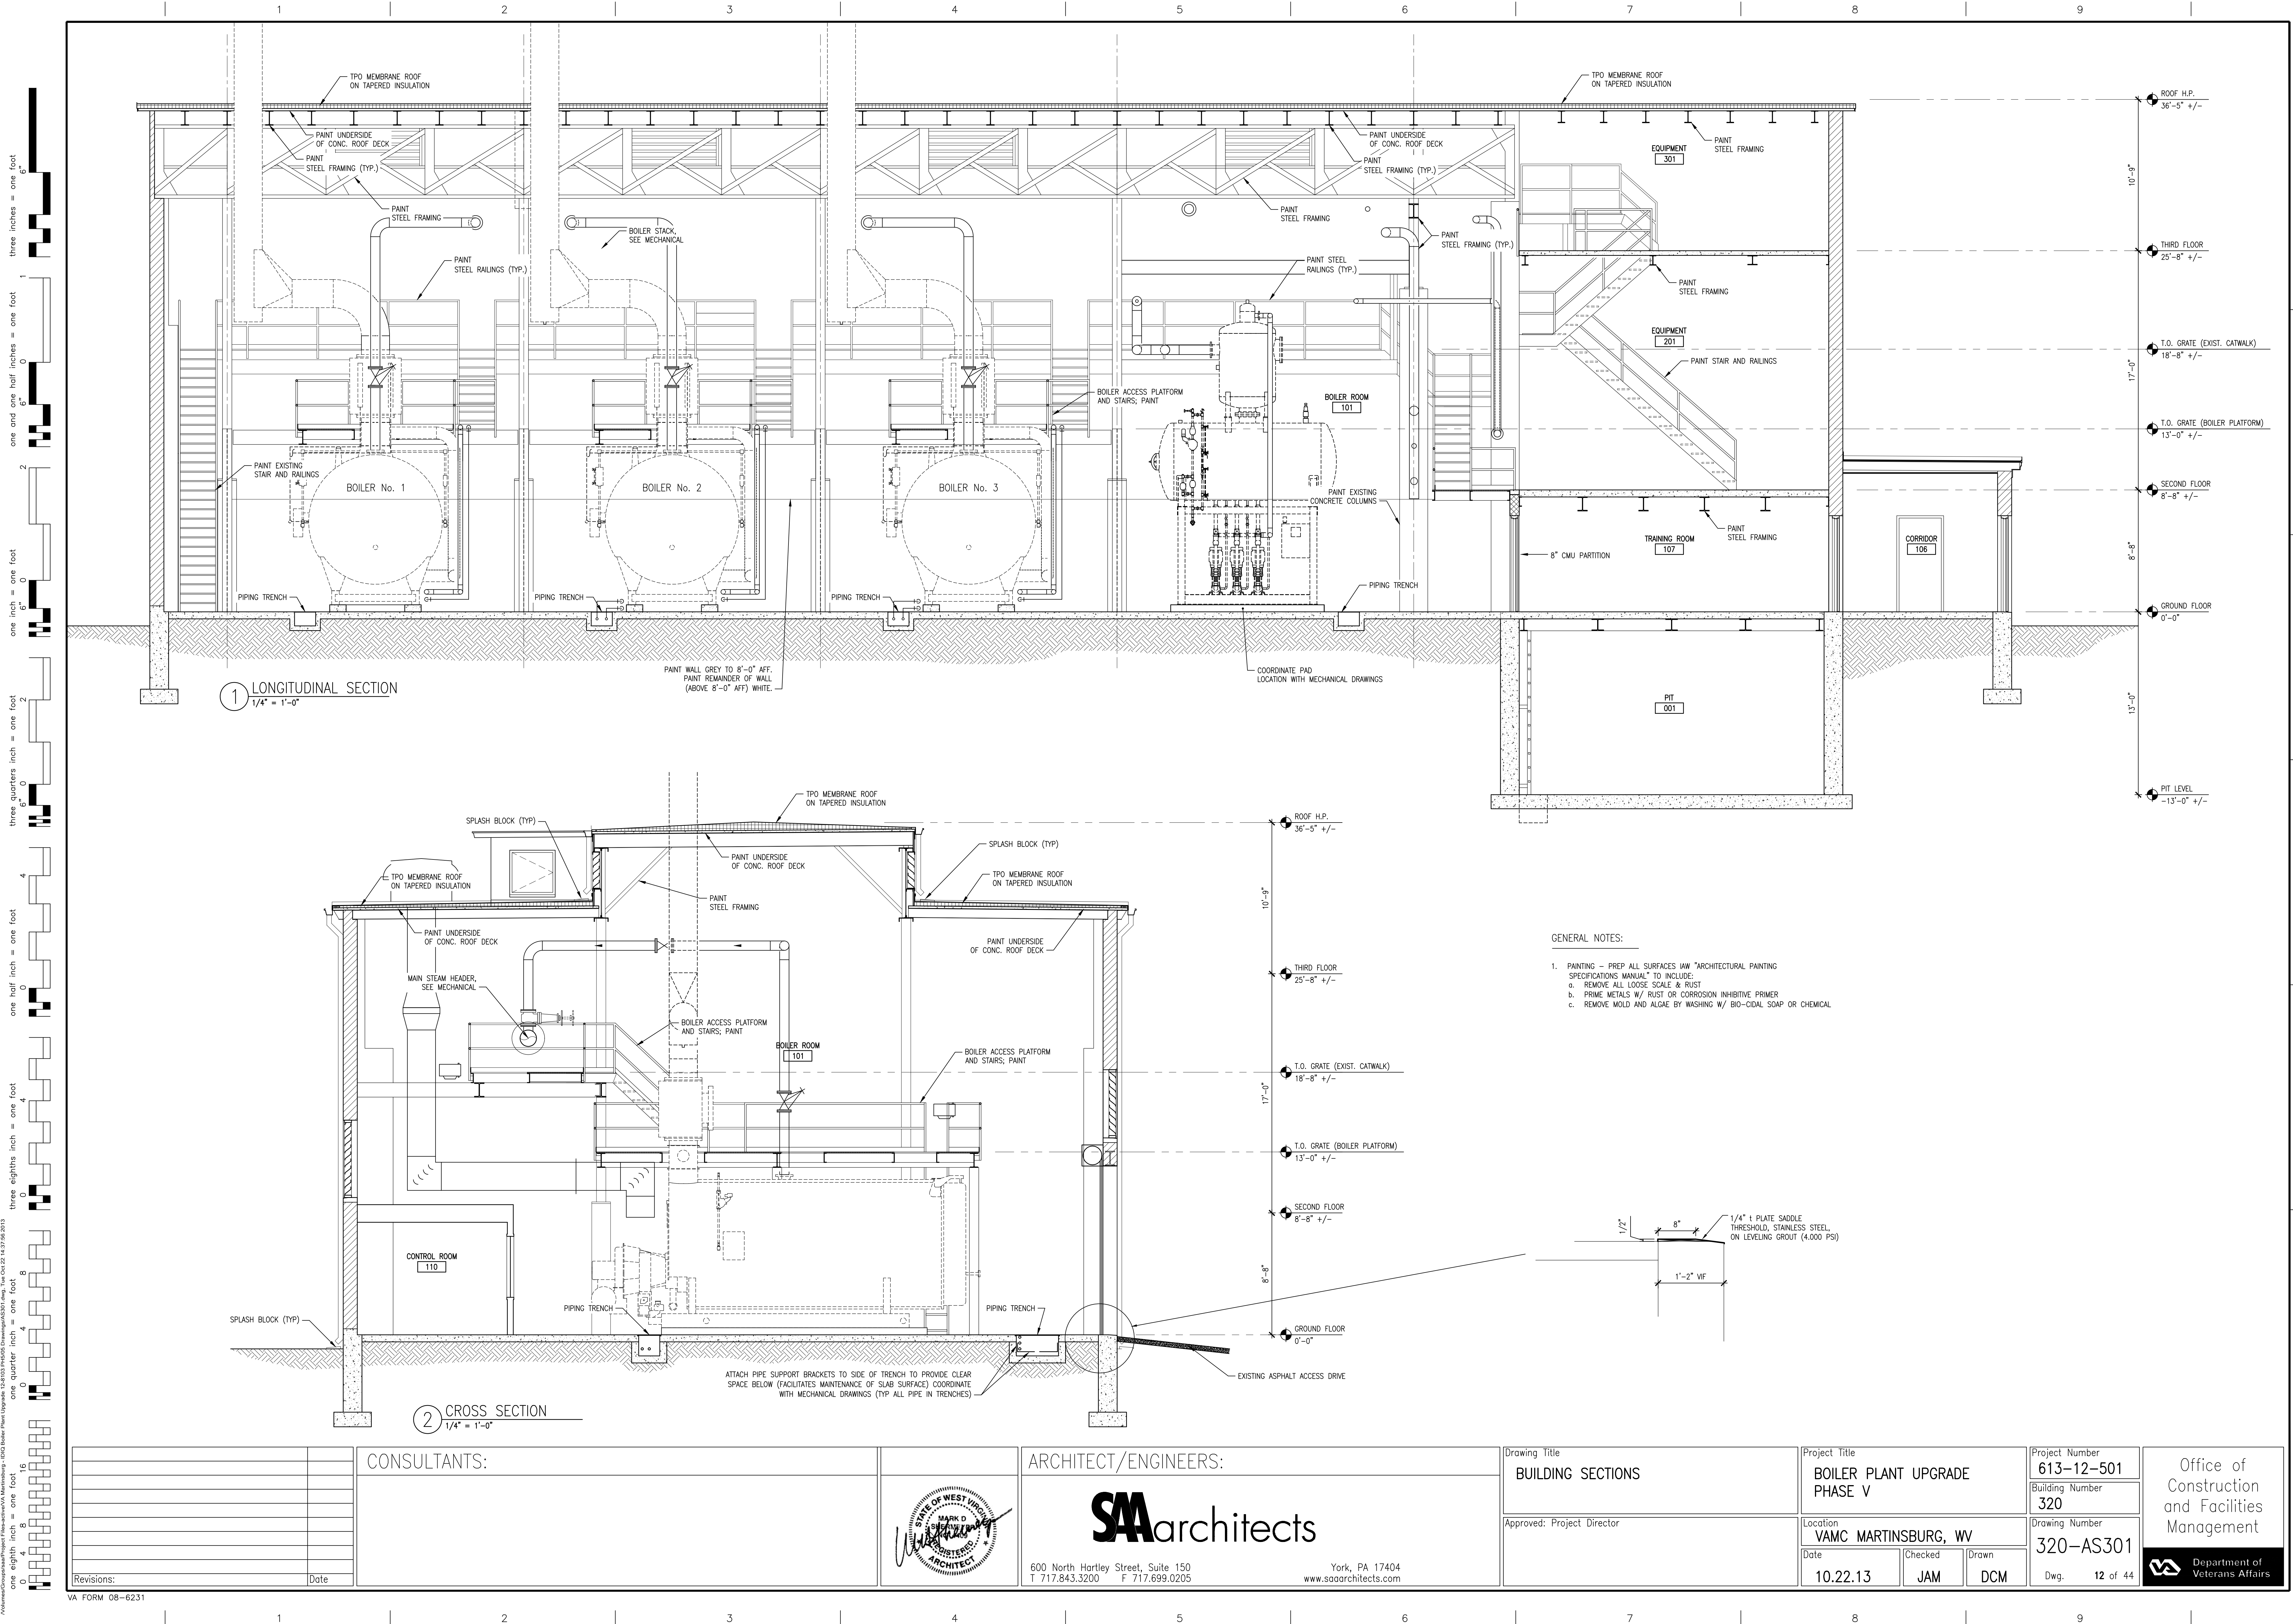



A

B

C

D

E

F

F

A

B

C

D


E

F


Revisions:  
16  
8  
4  
2  
0  
one eighth inch = one foot  
one quarter inch = one foot  
three eighths inch = one foot  
one half inch = one foot  
one inch = one foot  
three quarters inch = one foot  
one and one half inches = one foot  
two inches = one foot  
three inches = one foot

Project: VAMC Martinsburg - 600 S 165-33  
Drawing: 320-AS401  
Date: 10/22/13  
Author: JAM  
Checked: DCM  
Drawn: DCM


VA FORM 08-6231

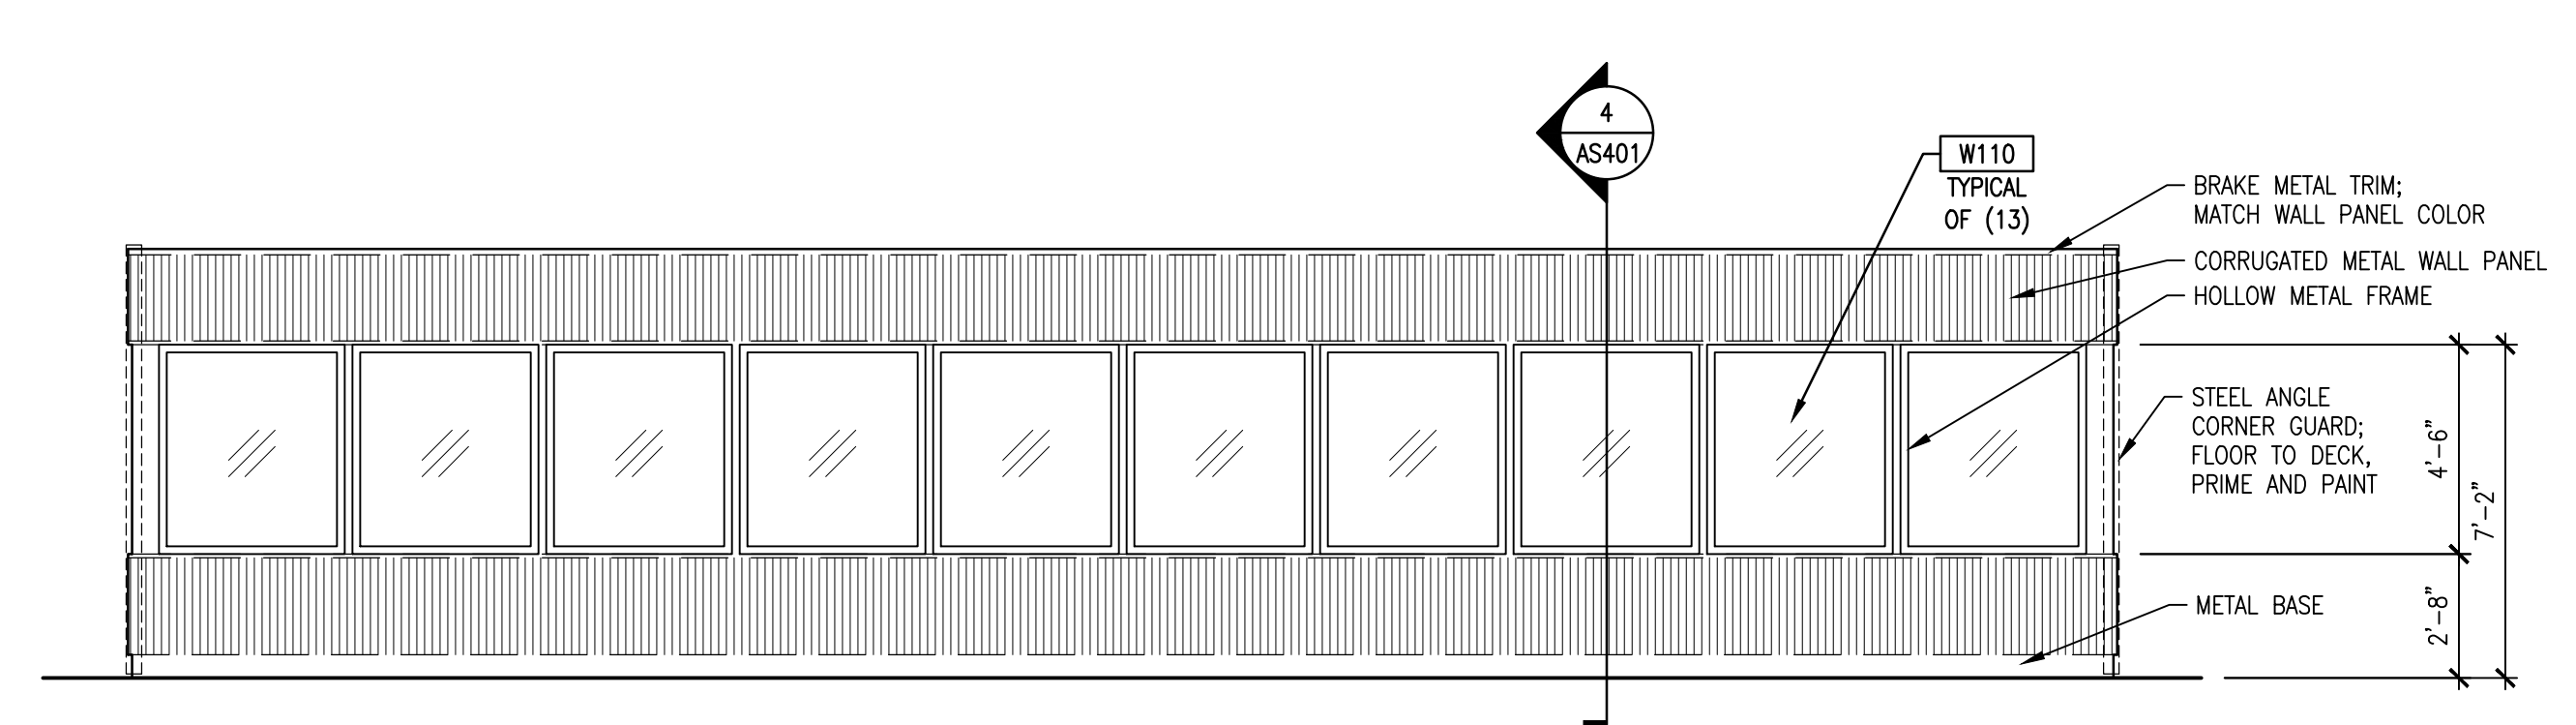

2 ELEVATION  
1/4" = 1'-0"

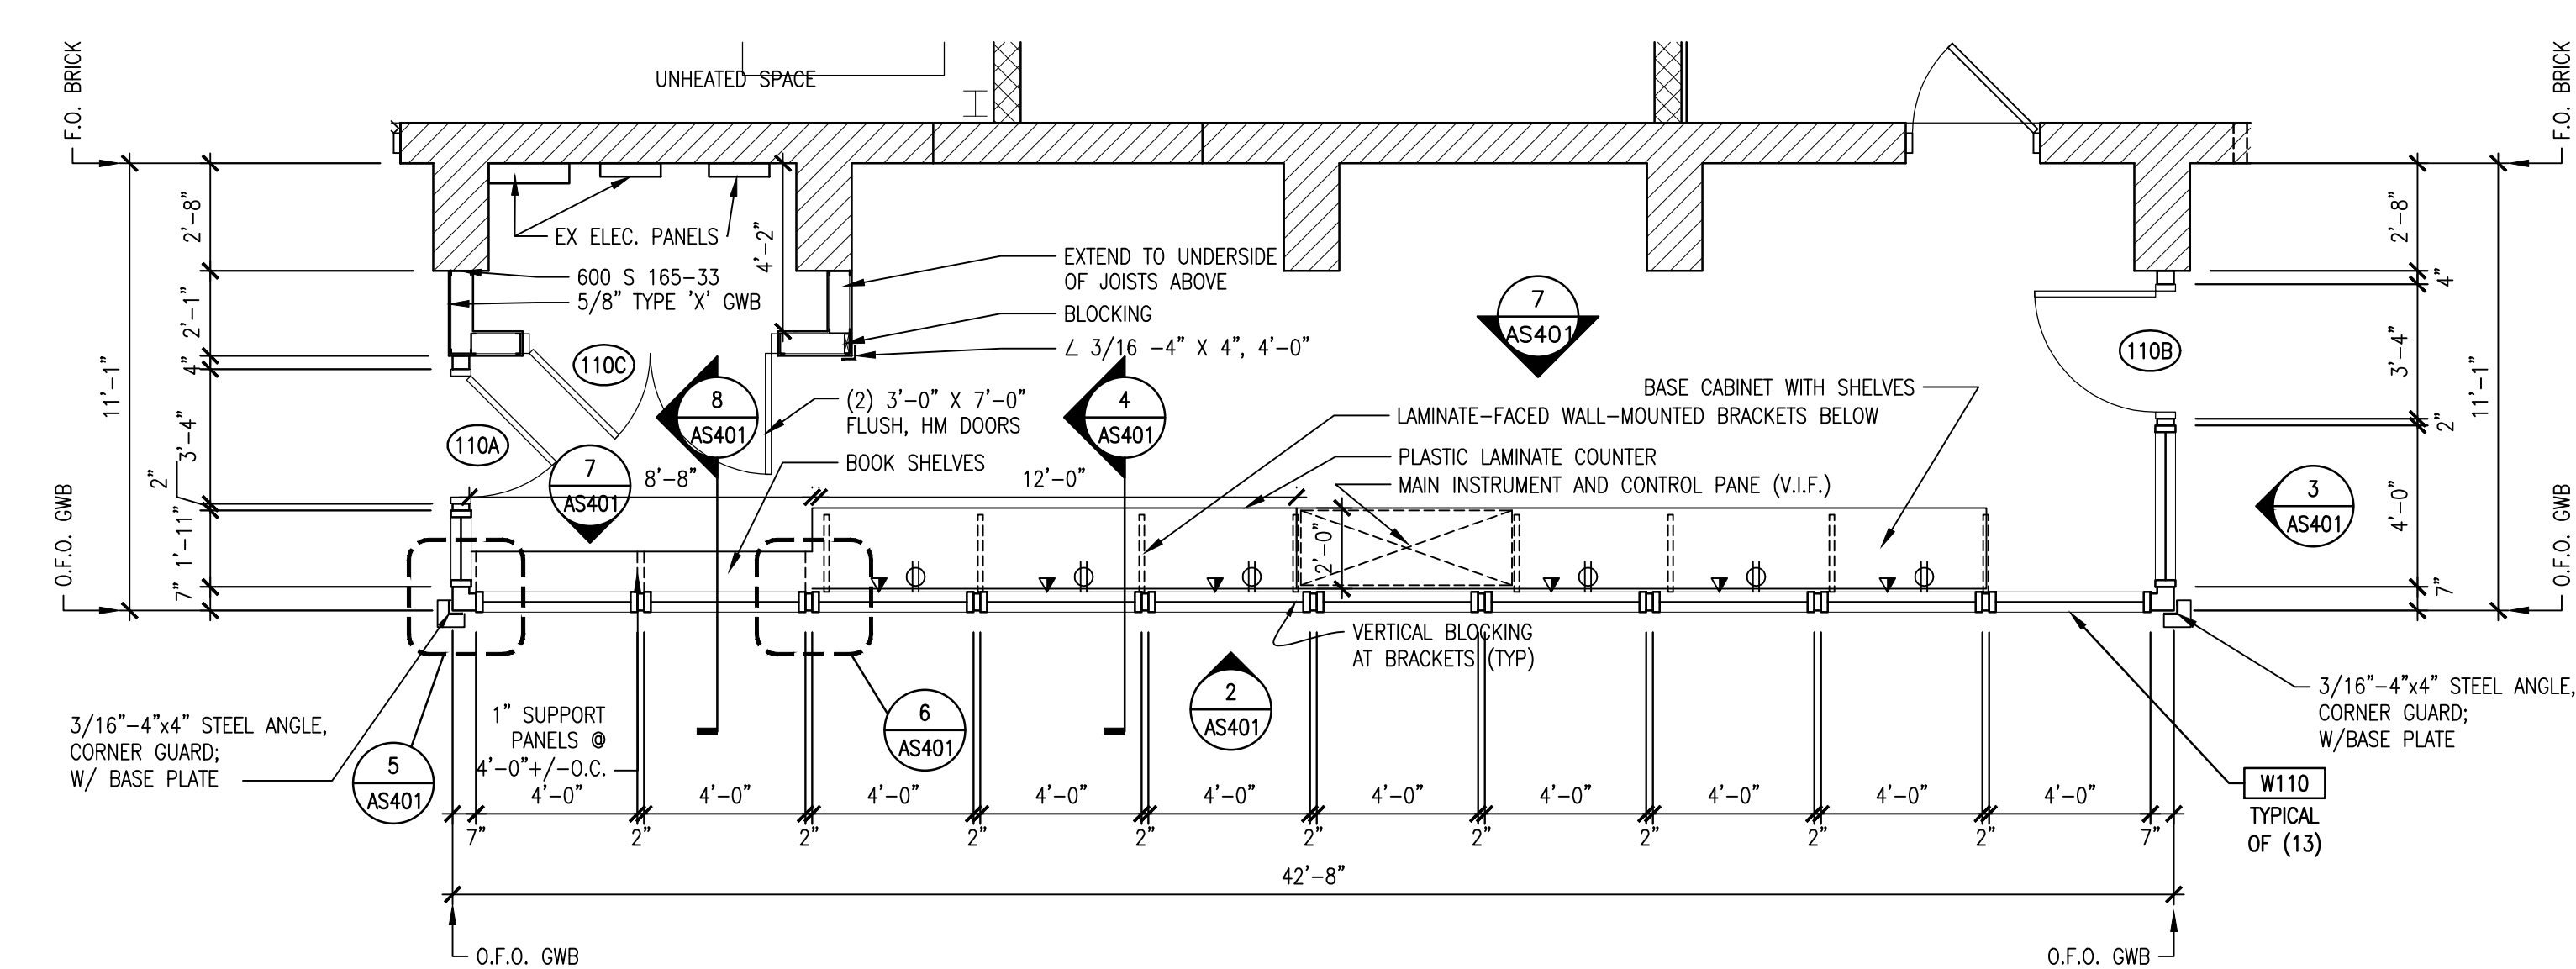


1 CONTROL ROOM PLAN  
1/4" = 1'-0"

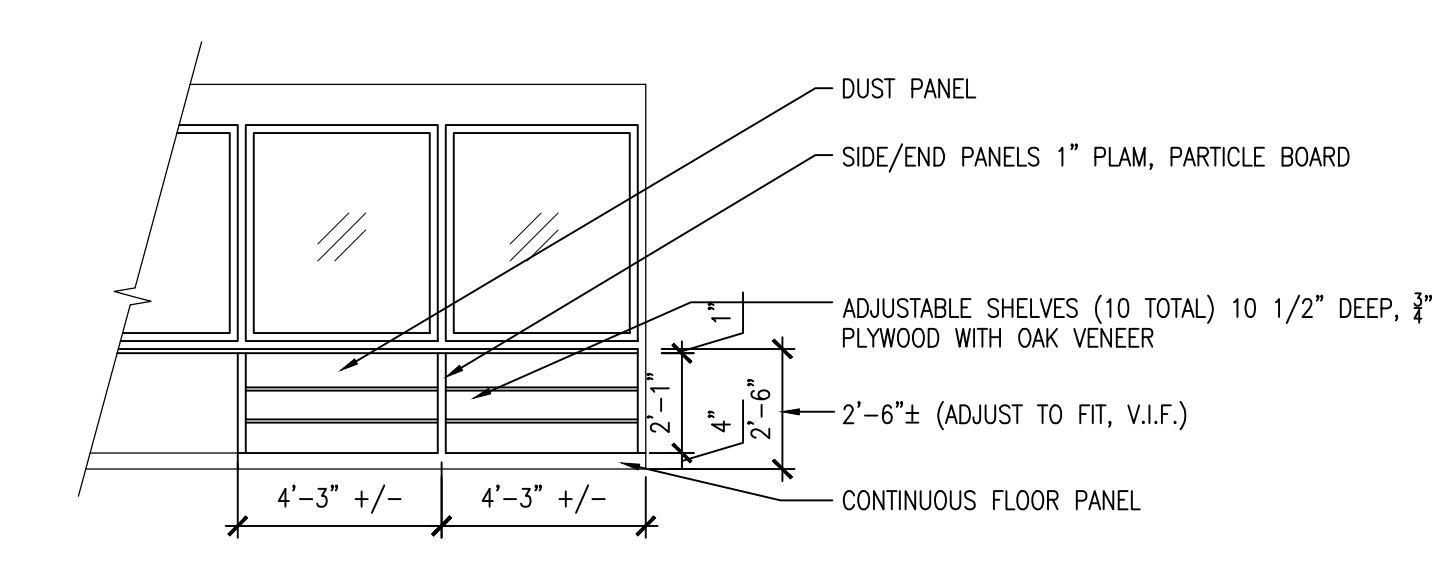


- NOTES:
1. PROVIDE METAL ADJUSTABLE SHELF SUPPORTS, MORTISE INTO SIDE SUPPORT PANELS.
  2. PROVIDE PLAM COUNTER TOP WITH BLACK, CONVEX VINYL EDGING.


7 ELEVATION - SHELVING - COUNTERTOP CABINET  
1/4" = 1'-0"

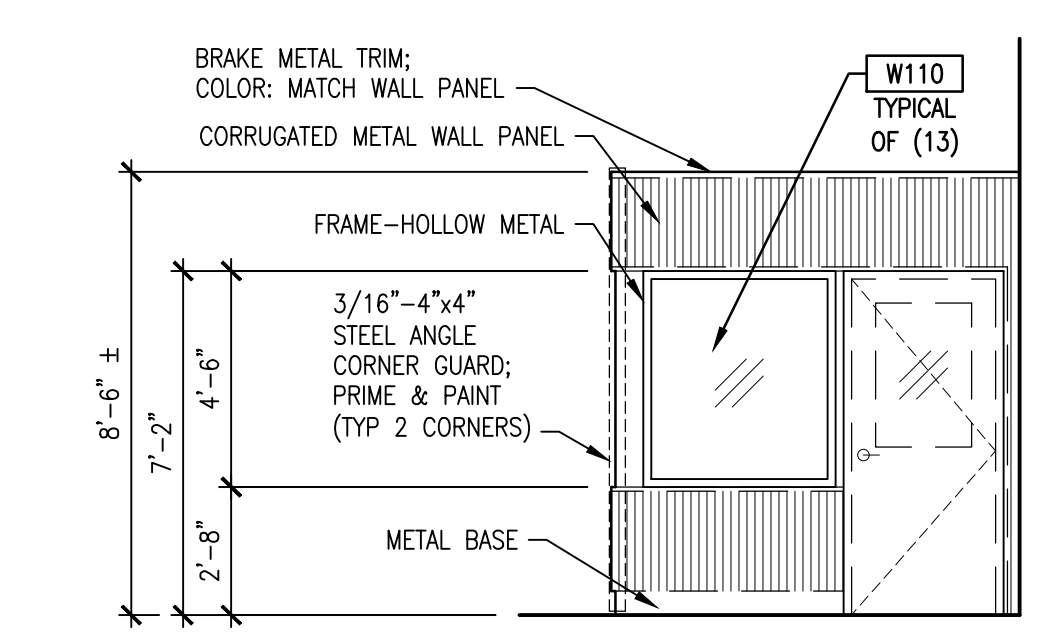


3 ELEVATION  
1/4" = 1'-0"

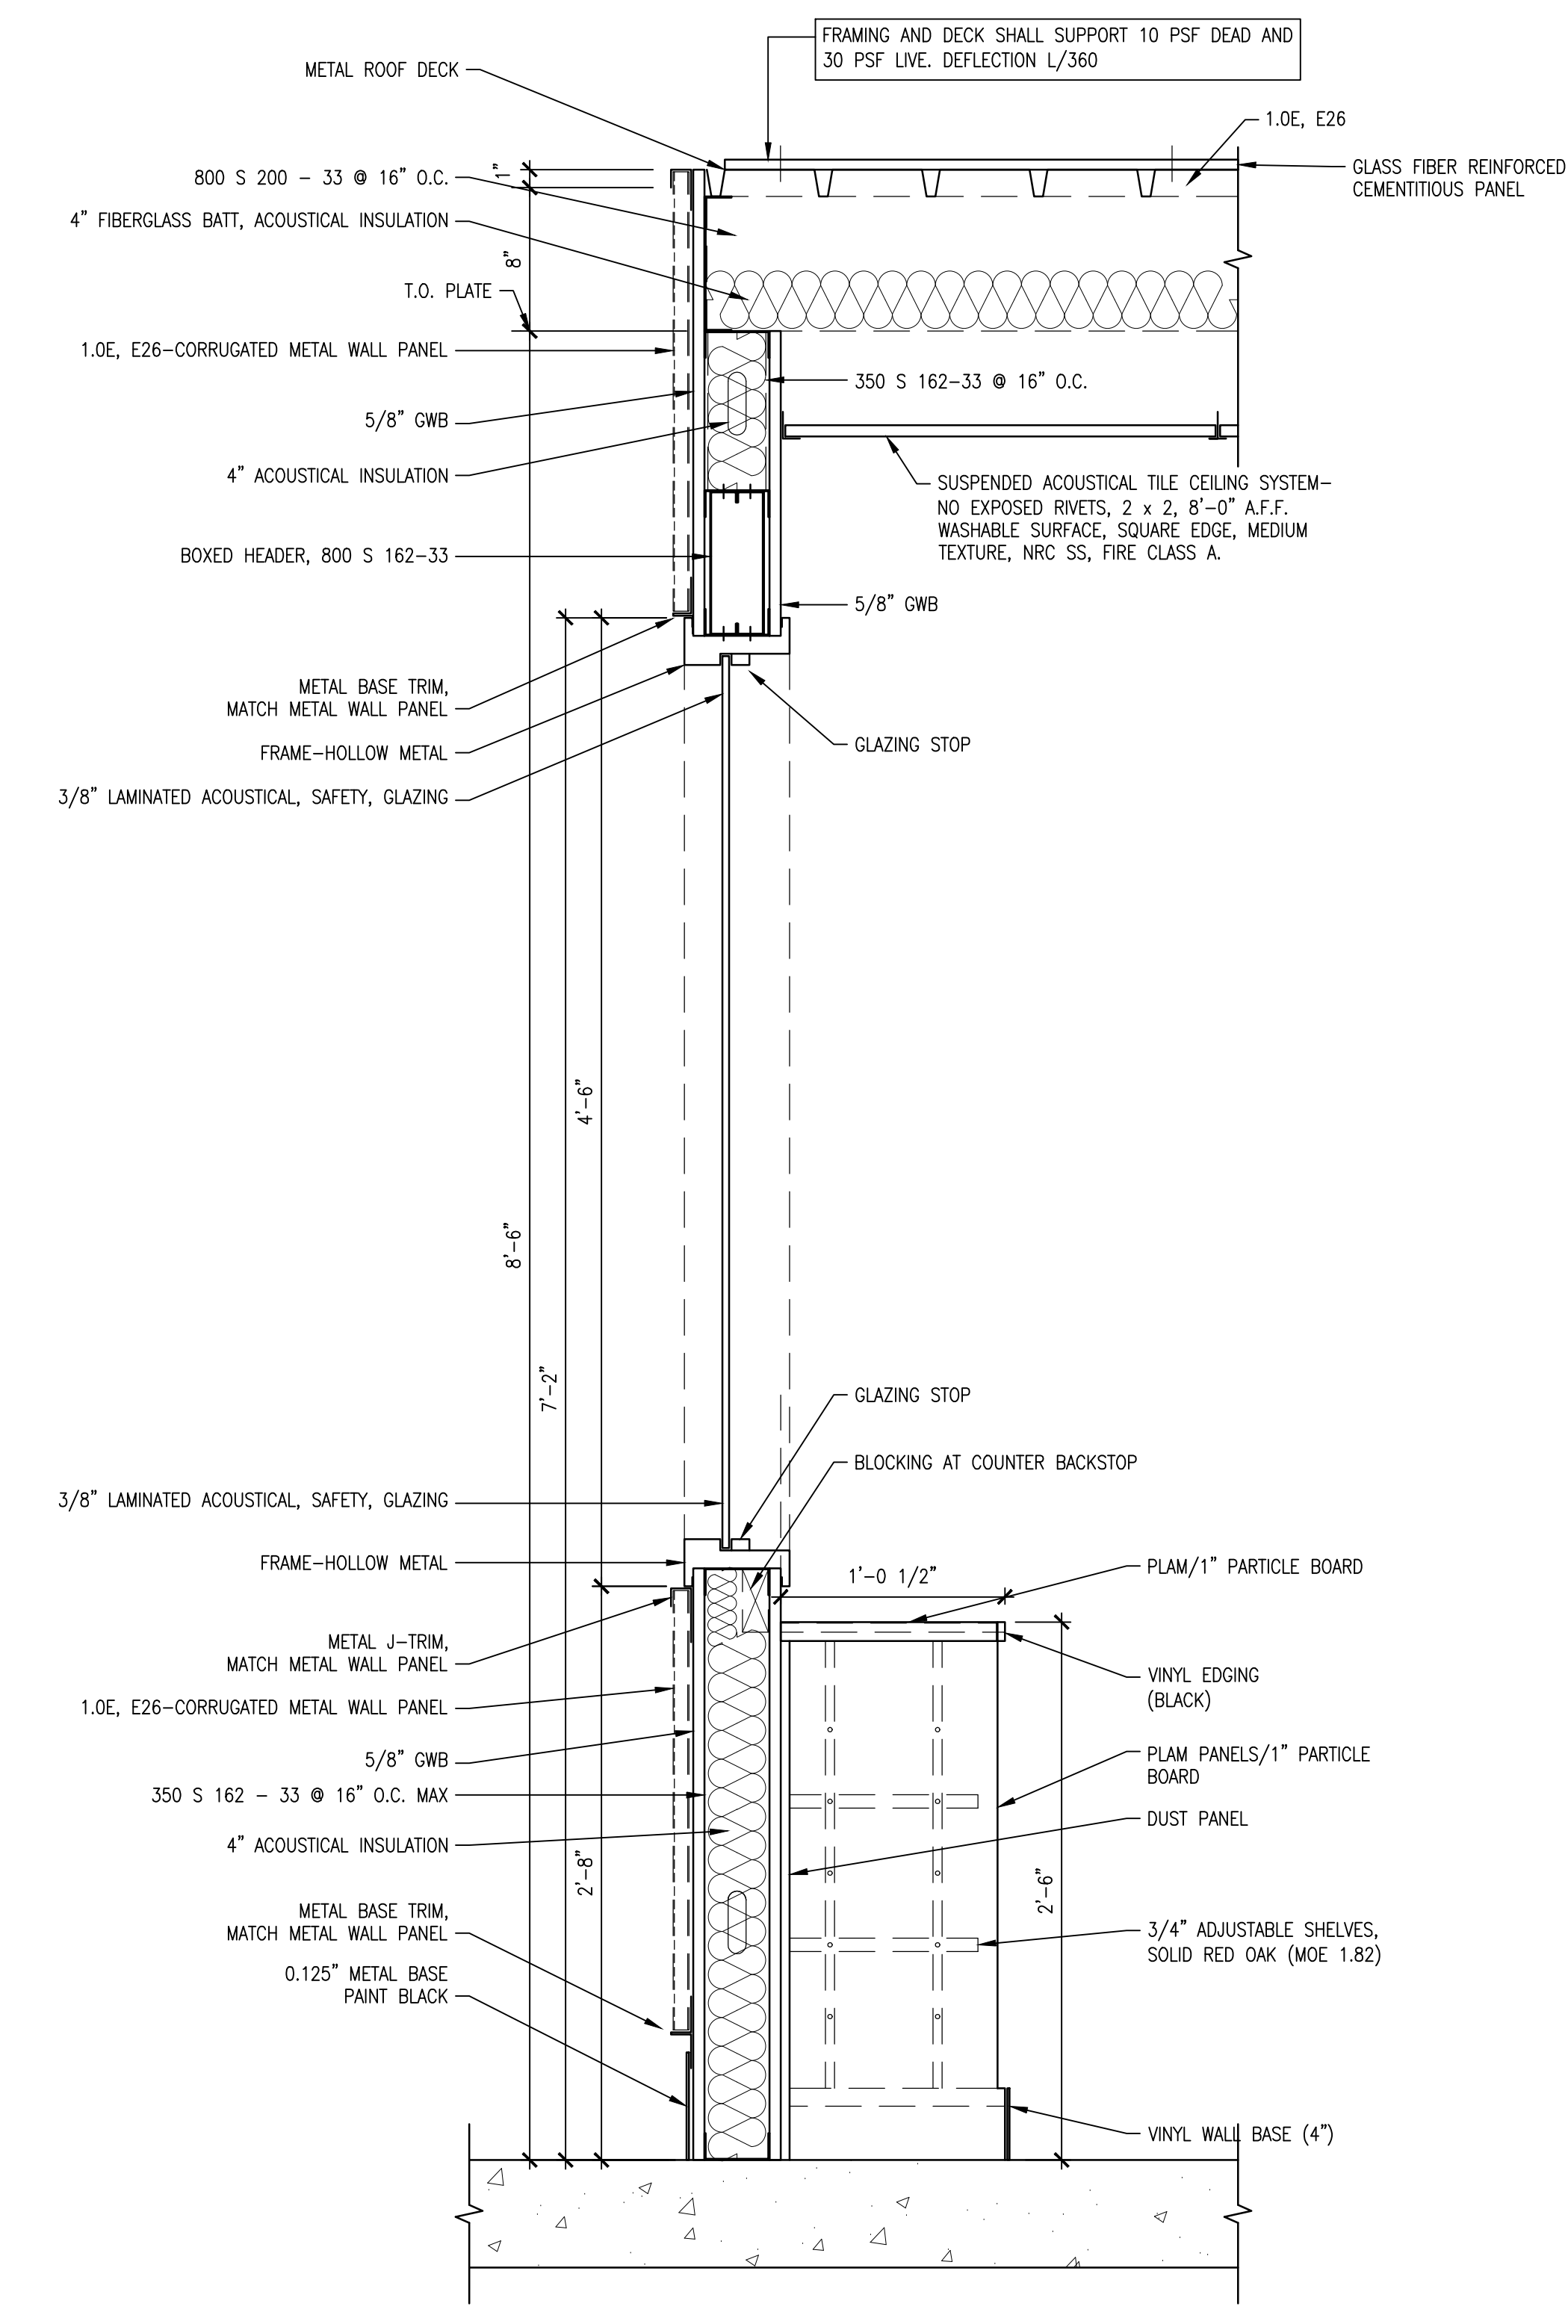


8 BOOKCASE  
1 1/2" = 1'-0"

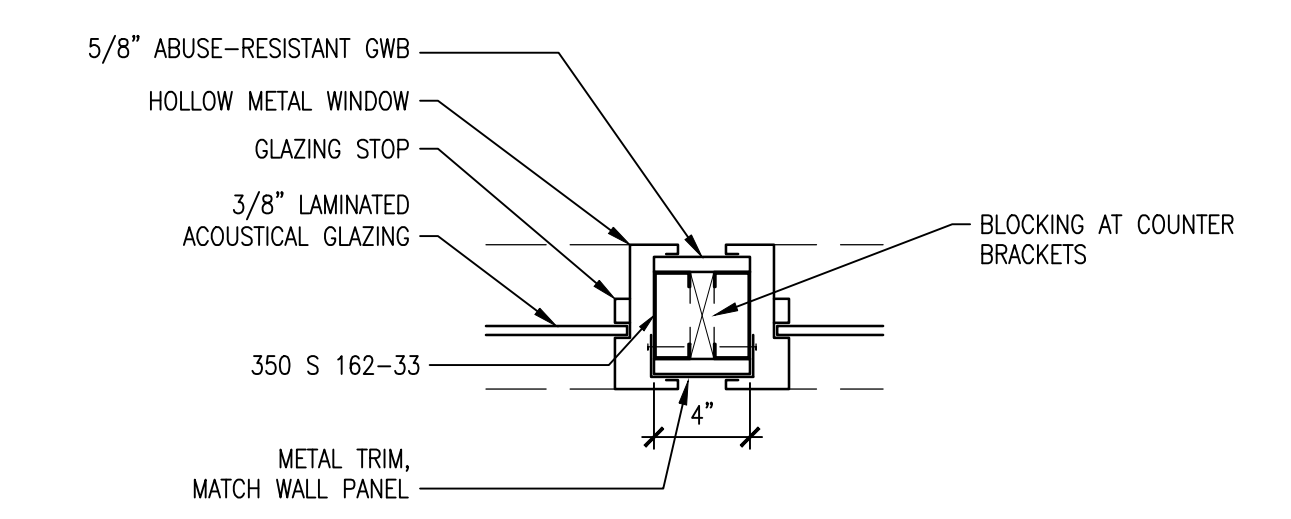

6 DETAIL  
1 1/2" = 1'-0"

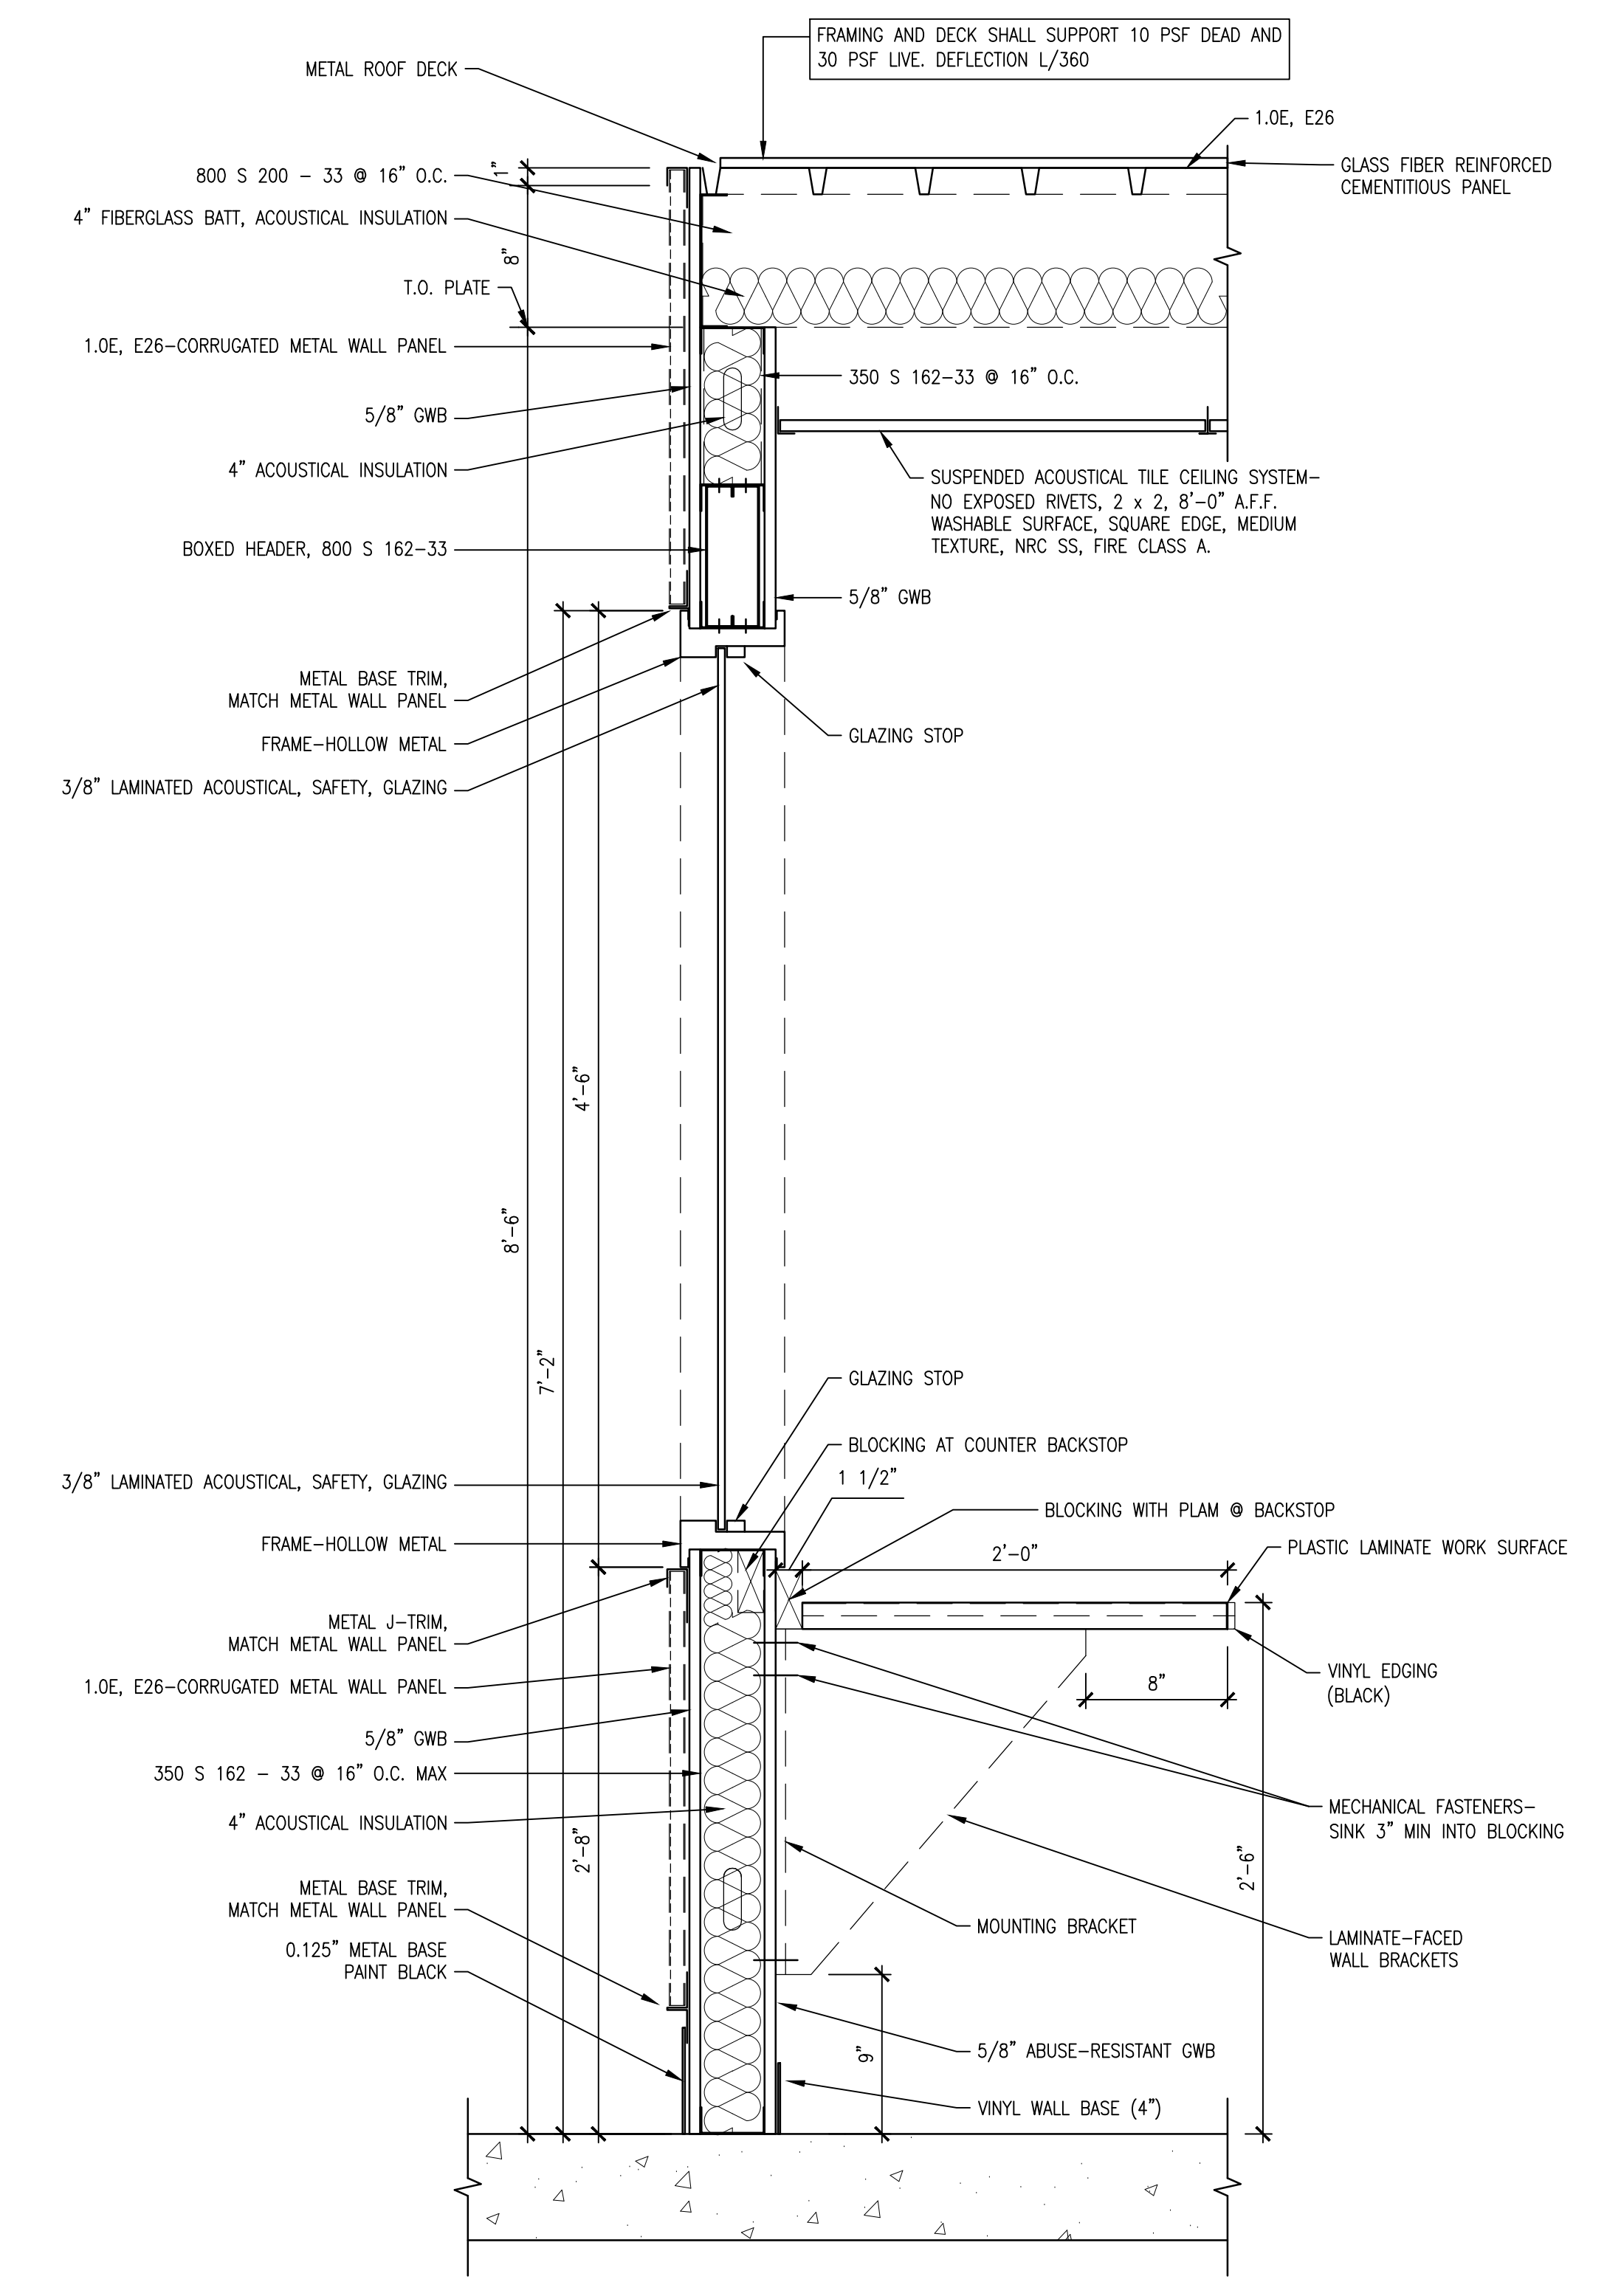

4 WALL SECTION  
1 1/2" = 1'-0"

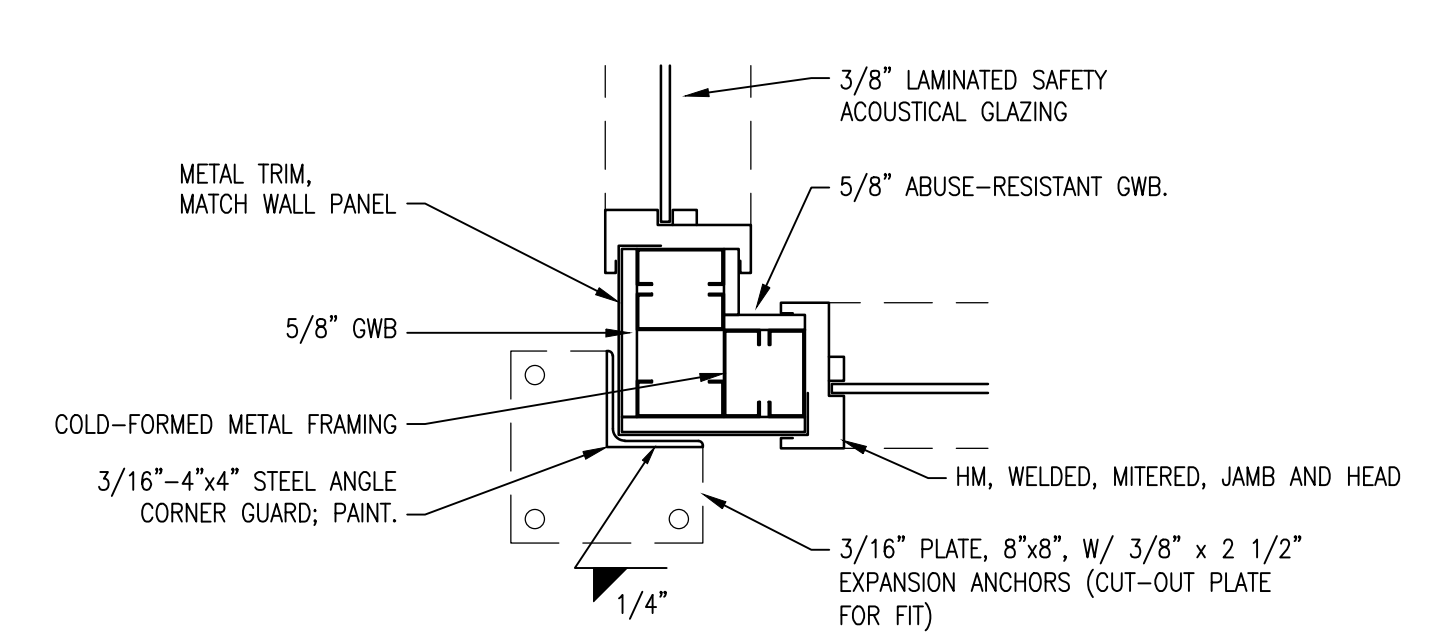

5 DETAIL  
1 1/2" = 1'-0"

CONSULTANTS:

ARCHITECT/ENGINEERS:

**SAA**architects

600 North Hartley Street, Suite 150  
T 717.843.3200 F 717.699.0205

York, PA 17404  
www.saaarchitects.com

Drawing Title  
**CONTROL ROOM**

Approved: Project Director

Project Title  
**BOILER PLANT UPGRADE  
PHASE V**

Location  
**VAMC MARTINSBURG, WV**

Date  
**10.22.13**

Checked  
**JAM**

Drawn  
**DCM**

Project Number  
**613-12-501**

Building Number  
**320**

Drawing Number  
**320-AS401**

Dwg. 13 of 44

Office of  
Construction  
and Facilities  
Management

Department of  
Veterans Affairs




DOOR SCHEDULE																
NO.	LOCATION	SIZE		DOOR						FRAME					HDW	NOTES
		WD	HT	TYPE	MATL	FIN	RATIN G	INSUL	GLAZ	TYPE	MATL	FIN	JAMB	HDR		
107B	TRAINING ROOM (107)	3'-0"	7'-0"	G	HM	PAINT	0	-	1/4" TEMP	2	HM	PAINT	J-1	H-1	11	-
110A	CONTROL ROOM (110)	3'-0"	7'-0"	G	HM	PAINT	0	-	1/4" TEMP	1	HM	PAINT	J-2	H-2	6	PUSH-PULL W/CLOSER & ACOUSTICAL SEALS
110B	CONTROL ROOM (110)	3'-0"	7'-0"	G	HM	PAINT	0	-	1/4" TEMP	1	HM	PAINT	J-2	H-2	6	PUSH-PULL W/CLOSER & ACOUSTICAL SEALS
110C	CONTROL ROOM (110)	(2) 3'-0"	7'-0"	F	HM	PAINT	0	-	-	3	HM	PAINT	J-2	H-2	7	PASSAGE SET, NO LOCK


WINDOW SCHEDULE											
NO.	LOCATION	TYPE	R.O.*		WINDOW				GLAZ	HDW	NOTES
			WD	HT	TYPE	MATL	FIN	RATING			
W110	CONTROL ROOM 110	A	4'-0"	4'-6"	A	HM	PAINT	0	LG-1	-	TYPICAL OF (13) UNITS
W301	EQUIPMENT 301	A	4'-9"	5'-7"	A	AL	PREFIN	0	IG-2	-	FIXED
G-1		1/4" TEMPERED SAFETY GLASS									
IG-1		NOT USED									
IG-2		1" INSULATED, LOW-E, TEMPERED									
LG-1		3/8" LAMINATED ACOUSTICAL GLAZING									
* ROUGH OPENING DIMENSIONS ARE PROVIDED FOR ESTIMATING PURPOSES ONLY. CONTRACTOR SHALL MEASURE OPENINGS IN FIELD PRIOR TO FABRICATION.											

ROOM FINISH SCHEDULE						
NO.	NAME	FLOOR	BASE	WALL	CEILING	NOTES
101	BOILER ROOM	CONCRETE	EFTR	PAINT*	ES, PAINT	PREP AND PAINT ALL EXPOSED STEEL
102	BREAK ROOM	-	-	-	-	EXISTING FINISHES TO REMAIN
103	OFFICE	-	-	-	-	EXISTING FINISHES TO REMAIN
104	OFFICE	-	-	-	-	EXISTING FINISHES TO REMAIN
105	LAB	-	-	-	-	EXISTING FINISHES TO REMAIN
105.1	JANITORIAL	-	-	-	-	EXISTING FINISHES TO REMAIN
Z101	STAIR	-	-	-	-	EXISTING FINISHES TO REMAIN
106	CORRIDOR	-	-	-	-	EXISTING FINISHES TO REMAIN
107	TRAINING ROOM	VCT	EFTR	PAINT	ES, PAINT	-
108	LOCKER ROOM	-	-	-	-	EXISTING FINISHES TO REMAIN
109	TOILET ROOM	-	-	-	-	EXISTING FINISHES TO REMAIN
110	CONTROL ROOM	VCT	VB/MB (OUTSIDE)	PAINT	AT	-
111	STORAGE	-	-	-	-	EXISTING FINISHES TO REMAIN
112	SHED	-	-	-	-	EXISTING FINISHES TO REMAIN
201	DEAERATOR	X CONC, PAINT	PAINT	PAINT	ES, PAINT	-
202	ELEC.	-	-	-	-	EXISTING FINISHES TO REMAIN
203	HVAC ACCESS	-	-	-	-	EXISTING FINISHES TO REMAIN
301	SURGE TANK	X CONC, PAINT	PAINT	PAINT	ES, PAINT	-
* PAINT COLOR: 2 COLORS - V.I.F.						


FINISH SCHEDULE ABBREVIATIONS	
ABBREVIATION	MATL.
AT	ACOUSTICAL CEILING
CONC	CONCRETE
CMU	CONCRETE MASONRY UNIT
ES	EXPOSED STRUCTURE
EFTR	EXISTING FINISHES TO REMAIN
GWB	GYPNUM WALL BOARD
MB	METAL BASE
VB	VINYL BASE
VCT	VINYL COMPOSITION TILE
X	EXISTING

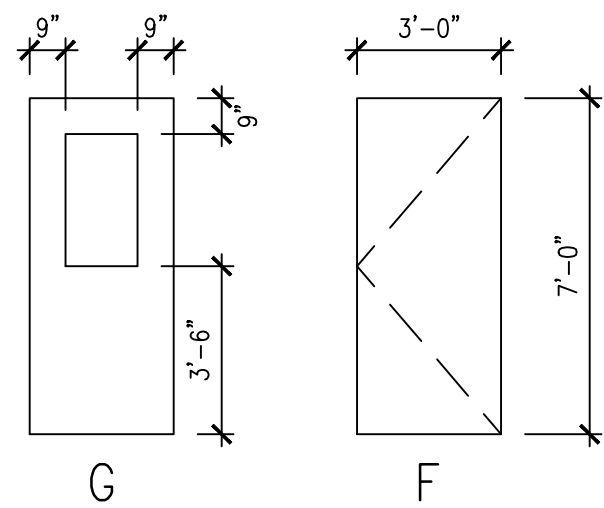


1 DOOR TYPES  
1/4" = 1'-0"

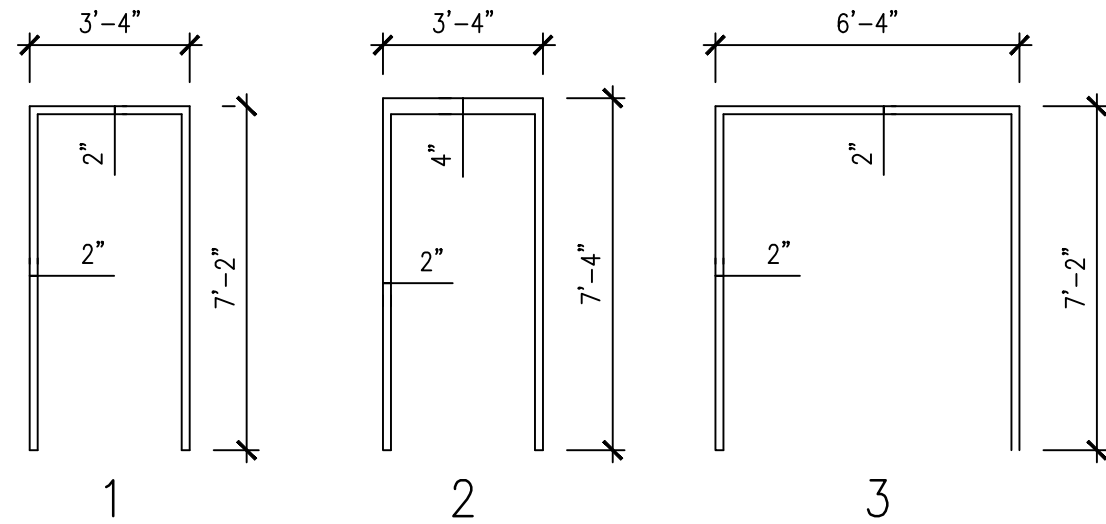


2 FRAME TYPES  
1/4" = 1'-0" ALL FRAMES WELDED

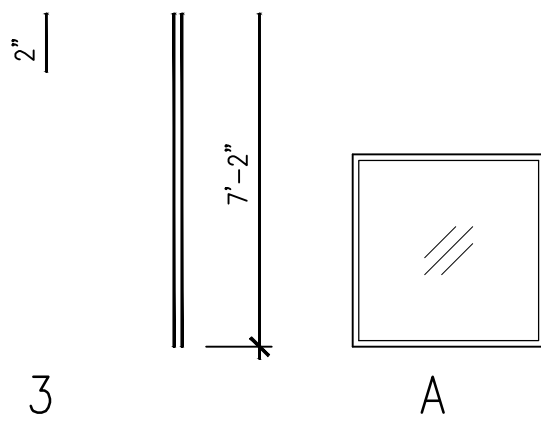


3 WINDOW TYPES  
1/4" = 1'-0"

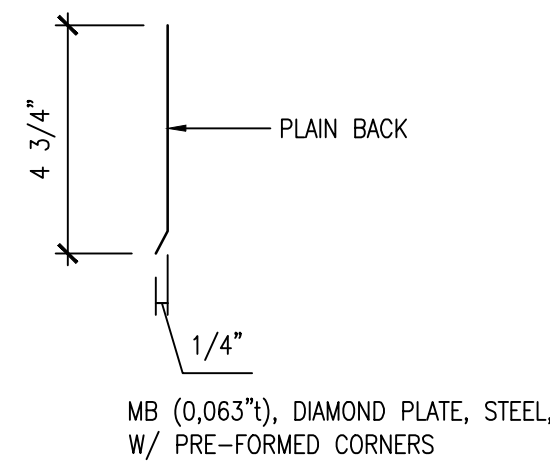


4 METAL - BASE  
3" = 1'-0"

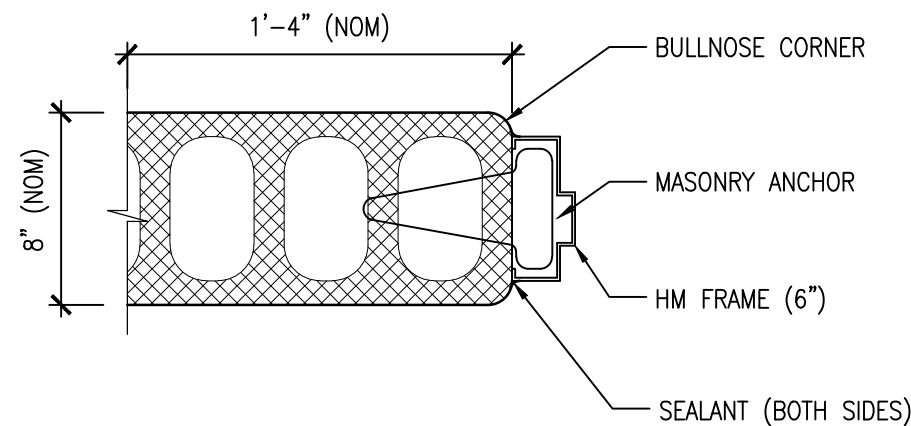


J-1  
SCALE: 1 1/2" = 1'-0"

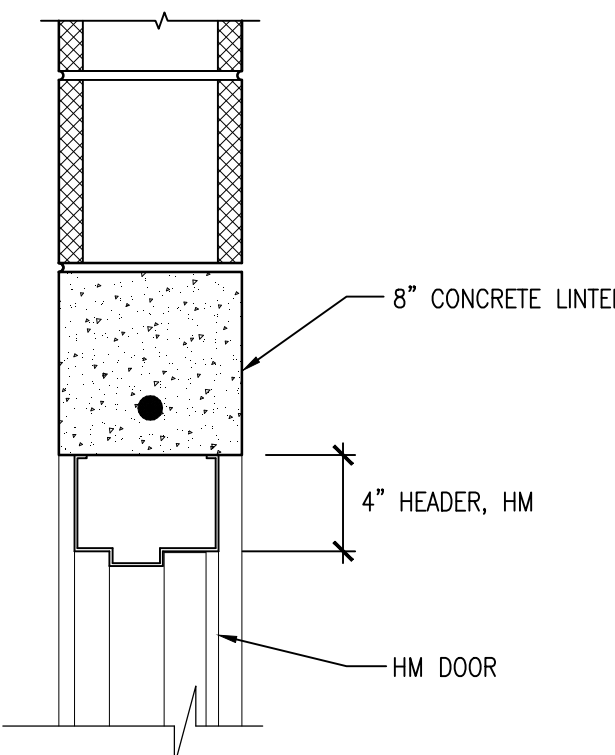

H-1  
SCALE: 1 1/2" = 1'-0"

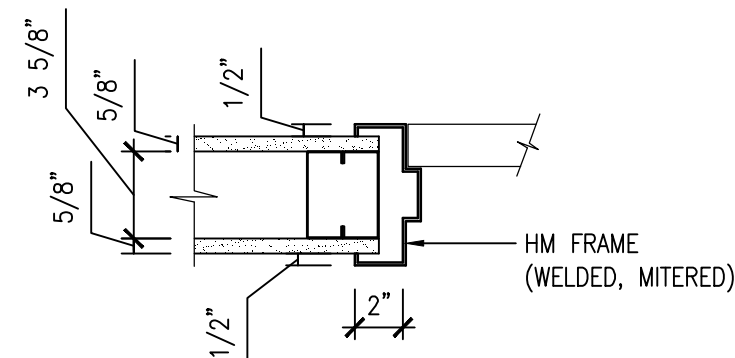

J-2  
SCALE: 1 1/2" = 1'-0"

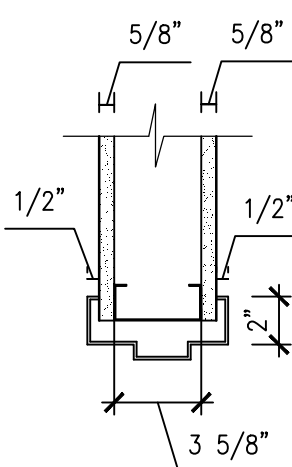


H-2  
SCALE: 1 1/2" = 1'-0"

Revisions:	Date:	CONSULTANTS:	ARCHITECT/ENGINEERS:	Drawing Title SCHEDULES	Project Title BOILER PLANT UPGRADE PHASE V	Project Number 613-12-501 Building Number 320	Office of Construction and Facilities Management
				Approved: Project Director	Location VAMC MARTINSBURG, WV	Drawing Number 320-AS501	
					Date 10.22.13	Checked JAM	
						Drawn DCM	
						Dwg. 14 of 44	







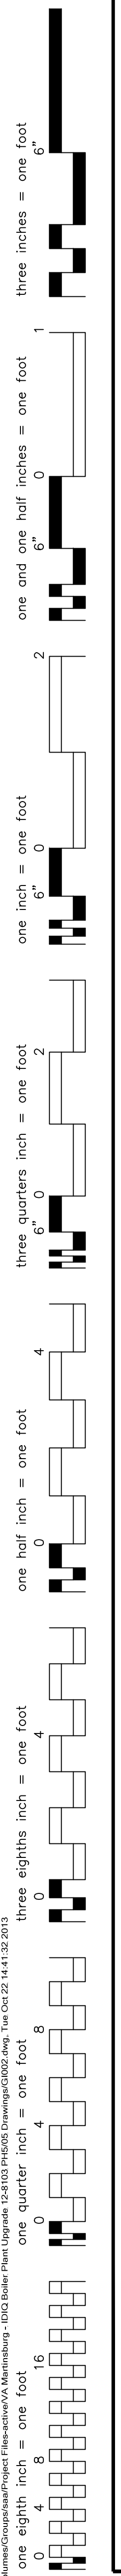

ARCHITECTURAL ABBREVIATIONS

A LABEL	CLASS A DOOR	CB	CATCH BASIN OR CORNER BEAD	DR	DOOR, DRAIN, DRESSING ROOM, OR DRIVE	FS	FEDERAL SPECIFICATION	LH	LEFT HAND	OC	ON CENTER	REFR	REFRIGERATION REFRACTORY	T	TREAD
A/C	AIR CONDITION	CBB	CEMENTITIOUS (BACKER) BOARD	DR CL	DOOR CLOSER	FSNTR	FASTENER	LHR	LEFT HAND REVERSE	OC	OCCUPY/OCCUPANT(S)	REG	REGISTER	T&G	TONGUE AND GROOVE
A/C UNIT	AIR CONDITIONING UNIT	CC	CUBIC CENTIMETER	DR FR	DOOR FRAME	FT	FEET OR FOOT	LHR	LEFT HAND REVERSE LATENT	OCC	OCCUPY/OCCUPANT(S)	REIN	REINFORCE	T&M	TIME AND MATERIALS
A/E	ARCHITECT/ENGINEER	CCTV	CLOSED CIRCUIT TELEVISION	DR OPNG	DOOR OPENING	FTG	FOOTING	LIB	LIBRARY	OD	OUTSIDE DIAMETER OUTSIDE	REP	REPAIR	TB	THROUGH BOLT OR TOWEL BAR
AAMA	AMERICAN ARCHITECTURAL MANUFACTURERS ASSOCIATION	CW	COUNTERCLOCKWISE	DS	DRAIN	FURNG	FURRING	LIN	LINEPHONE	OD	OUTSIDE DIAMETER OUTSIDE	REPL	REPLACE	TC	THE TOWEL BAR
AB	ANCHOR BOLT	CD	CONSTRUCTION DOCUMENTS OR CONTRACT DOCUMENTS	DG	DESIGN	FURN	FURNITURE	LINO	LINOLEUM	OF/OI	OWNER FURNISHED/CONTRACTOR	REQ	REQUIRED	TC	TELEPHONE CONTROL PANEL; TRAFFIC CONTROL PLAN
ABC	AGGREGATE BASE COURSE	CEM	CEMENT	DGN	DESIGN	FUT	FUTURE	LIO	LIQUID	OF/OI	OWNER FURNISHED/CONTRACTOR	RESIL	RESILIENT	TD	TOWEL DISPENSER
AC	ASBESTOS CEMENT OR ASPHALTIC CONCRETE	CEM PLAS	CEMENT PLASTER	DW	DRAWING	FWC	FABRIC WALLCOVERING	LKR	LOCKER	OFD	OVERFLOW DRAIN	RET	RETURN	TECH	TECHNICAL
ACI	AMERICAN CONCRETE INSTITUTE	CER	CERAMIC	DWTR	DUMBWAITER	GA	GAGE OR GYPSUM ASSOCIATION	LKR RM	LOCKER ROOM	OFF	OFFICE	REV	REVISION	TEL	TELEPHONE
ACS DR	ACCESS DOOR	CF	CONTRACTOR	E	EAST	GAL	GALLON	LL	LEAD LINED	OF/OI	OWNER FURNISHED/OWNER	RF	RADIO FREQUENCY	TEMP	TEMPERATURE OR TEMPORARY
ACS FLR	ACCESS FLOOR	CF/OI	CONTRACTOR FURNISHED/OWNER	E LABEL	CLASS E DOOR	GALV	GALVANIC OR GALVANIZED	LLH	LONG LEG HORIZONTAL	OH	OVERHEAD (COILING) DOOR	RFG	ROOFING	TER	TERRAZZO
ACS PNL	ACCESS PANEL	CF/OI	CONTRACTOR FURNISHED/OWNER	EA	EACH	GALV STL	GALVANIZED STEEL	LLV	LONG LEG VERTICAL	OH DR	OVERHEAD (COILING) DOOR	RFP	REQUEST FOR PROPOSAL	THD	THREAD
ACST	ACOUSTICAL CEILING TILE	CF/OI	CONTRACTOR FURNISHED/OWNER	EF	EFFICIENCY	GB	GRAB BAR	LMS	LANDSCAPE	OPH	OPPOSITE HAND	RHS	RIGHT HAND	THRM	THERMAL
AD	AREA DRAIN	CFLG	COUNTERFLASHING	EF	EFFICIENCY	GC	GENERAL CONTRACTOR	LMST	LIMESTONE	OPH	OPPOSITE HAND	RHS	RIGHT HAND	THRM	THERMAL
ADA	AMERICANS WITH DISABILITIES	CFM	CUBIC FEET PER MINUTE	EJ	EXPANSION JOINT	GDR	GUARD RAIL	LR	LARGE	OPH	OPPOSITE HAND	RHS	RIGHT HAND	THRM	THERMAL
ADC	AUTOMATIC DOOR CLOSER	CFMF	COLD-FORMED METAL FRAMING	EL	ELEVATION	GEN	GENERAL OR GENERATOR	LRG	LARGE	OPH	OPPOSITE HAND	RHS	RIGHT HAND	THRM	THERMAL
ADDL	ADDITIONAL	CG	CENTER OF GRAVITY OR CORNER GUARD	ELAST	ELASTOMERIC	GFRG	GLASS-FIBER-REINFORCED	LS	LUMP SUM	OPH	OPPOSITE HAND	RHS	RIGHT HAND	THRM	THERMAL
ADDN	ADDITION	CGSFU	CERAMIC GLAZED STRUCTURAL FACING UNITS	ELEC	ELECTRIC	GFRP	GLASS-FIBER-REINFORCED	LT	LIGHT	OPH	OPPOSITE HAND	RHS	RIGHT HAND	THRM	THERMAL
ADH	ADHESIVE	CH BD	CHALKBOARD	ELEC DR OP	ELECTRIC DOOR OPENER	GI	GALVANIZED IRON	LT GA	LIGHT GAGE	OPH	OPPOSITE HAND	RHS	RIGHT HAND	THRM	THERMAL
ADJ	ADJUTANT, ADJOINING, OR ADJUSTABLE	CHM	CHEMICAL	EMER	EMERGENCY	GUT	GUTTER	LT WT	LIGHT WEIGHT	OPH	OPPOSITE HAND	RHS	RIGHT HAND	THRM	THERMAL
ADMIN	ADMINISTRATION	CHFR	CHAMFER	EMER SHR	EMERGENCY SHOWER	GL	GLASS	LTNG	LIGHTNING	OPH	OPPOSITE HAND	RHS	RIGHT HAND	THRM	THERMAL
ADB	AUTOMATIC DOOR BOTTOM	CHK	CHECK	ENCL	ENCLOSURE	GL BLK	GLASS BLOCK	LVD	LOUVERED	OPH	OPPOSITE HAND	RHS	RIGHT HAND	THRM	THERMAL
AFC	ABOVE FINISHED COUNTER	CHK	CHECK	ENCL	ENCLOSURE	GL BLK	GLASS BLOCK	LVD	LOUVERED	OPH	OPPOSITE HAND	RHS	RIGHT HAND	THRM	THERMAL
AFF	ABOVE FINISHED FLOOR	CHK	CHECK	ENCL	ENCLOSURE	GL BLK	GLASS BLOCK	LVD	LOUVERED	OPH	OPPOSITE HAND	RHS	RIGHT HAND	THRM	THERMAL
AFG	ABOVE FINISHED GRADE	CHK	CHECK	ENCL	ENCLOSURE	GL BLK	GLASS BLOCK	LVD	LOUVERED	OPH	OPPOSITE HAND	RHS	RIGHT HAND	THRM	THERMAL
AFS	ABOVE FINISHED SLAB	CHK	CHECK	ENCL	ENCLOSURE	GL BLK	GLASS BLOCK	LVD	LOUVERED	OPH	OPPOSITE HAND	RHS	RIGHT HAND	THRM	THERMAL
AGA	AMERICAN GAS ASSOCIATION	CHK	CHECK	ENCL	ENCLOSURE	GL BLK	GLASS BLOCK	LVD	LOUVERED	OPH	OPPOSITE HAND	RHS	RIGHT HAND	THRM	THERMAL
AGC	ASSOCIATED GENERAL CONTRACTORS	CHK	CHECK	ENCL	ENCLOSURE	GL BLK	GLASS BLOCK	LVD	LOUVERED	OPH	OPPOSITE HAND	RHS	RIGHT HAND	THRM	THERMAL
AGGR	AGGREGATE	CHK	CHECK	ENCL	ENCLOSURE	GL BLK	GLASS BLOCK	LVD	LOUVERED	OPH	OPPOSITE HAND	RHS	RIGHT HAND	THRM	THERMAL
AHJ	AUTHORITY HAVING JURISDICTION	CHK	CHECK	ENCL	ENCLOSURE	GL BLK	GLASS BLOCK	LVD	LOUVERED	OPH	OPPOSITE HAND	RHS	RIGHT HAND	THRM	THERMAL
AWS	AMERICAN WELDING SOCIETY	CHK	CHECK	ENCL	ENCLOSURE	GL BLK	GLASS BLOCK	LVD	LOUVERED	OPH	OPPOSITE HAND	RHS	RIGHT HAND	THRM	THERMAL
AWT	ACOUSTICAL WALL TREATMENT	CHK	CHECK	ENCL	ENCLOSURE	GL BLK	GLASS BLOCK	LVD	LOUVERED	OPH	OPPOSITE HAND	RHS	RIGHT HAND	THRM	THERMAL
B LABEL	CLASS B DOOR	CTB	CERAMIC TILE BASE	CTF	COATING	CTG	CENTER CONTOUR	CTR	CONTROL	CTV	CABLE TELEVISION	CU	COPPER C	CU FT	CUBIC FEET
B PL	BASE PLATE	CTB	CERAMIC TILE BASE	CTF	COATING	CTG	CENTER CONTOUR	CTR	CONTROL	CTV	CABLE TELEVISION	CU	COPPER C	CU FT	CUBIC FEET
BALC	BALCONY	CTB	CERAMIC TILE BASE	CTF	COATING	CTG	CENTER CONTOUR	CTR	CONTROL	CTV	CABLE TELEVISION	CU	COPPER C	CU FT	CUBIC FEET
BAT	BATTEN	CTB	CERAMIC TILE BASE	CTF	COATING	CTG	CENTER CONTOUR	CTR	CONTROL	CTV	CABLE TELEVISION	CU	COPPER C	CU FT	CUBIC FEET
BB	BULLETIN BOARD	CTB	CERAMIC TILE BASE	CTF	COATING	CTG	CENTER CONTOUR	CTR	CONTROL	CTV	CABLE TELEVISION	CU	COPPER C	CU FT	CUBIC FEET
BD	BOARD	CTB	CERAMIC TILE BASE	CTF	COATING	CTG	CENTER CONTOUR	CTR	CONTROL	CTV	CABLE TELEVISION	CU	COPPER C	CU FT	CUBIC FEET
BD FT	BOARD FEET (FOOT)	CTB	CERAMIC TILE BASE	CTF	COATING	CTG	CENTER CONTOUR	CTR	CONTROL	CTV	CABLE TELEVISION	CU	COPPER C	CU FT	CUBIC FEET
BEV	BEVEL	CTB	CERAMIC TILE BASE	CTF	COATING	CTG	CENTER CONTOUR	CTR	CONTROL	CTV	CABLE TELEVISION	CU	COPPER C	CU FT	CUBIC FEET
BHMA	BUILDER'S HARDWARE MANUFACTURER'S ASSOCIATION	CTB	CERAMIC TILE BASE	CTF	COATING	CTG	CENTER CONTOUR	CTR	CONTROL	CTV	CABLE TELEVISION	CU	COPPER C	CU FT	CUBIC FEET
BI FL DR	BIFOLDING DOORS	CTB	CERAMIC TILE BASE	CTF	COATING	CTG	CENTER CONTOUR	CTR	CONTROL	CTV	CABLE TELEVISION	CU	COPPER C	CU FT	CUBIC FEET
BITUM	BITUMINOUS	CTB	CERAMIC TILE BASE	CTF	COATING	CTG	CENTER CONTOUR	CTR	CONTROL	CTV	CABLE TELEVISION	CU	COPPER C	CU FT	CUBIC FEET
 EXIT (ILLUMINATED)


EXIT ACCESS ARRANGEMENT  
FOR BUILDINGS WITH SPRINKLER SYSTEM, SEPARATION DISTANCE OF EXIT  
DOORS OR EXIT ACCESS DOORWAYS SHALL BE NOT LESS THAN 1/3 THE LENGTH  
OF THE MAXIMUM OVERALL DIAGONAL DIMENSION OF THE AREA SERVED.  
[§1015.2.1 EXCEPTION 2.]

 

 


Department of  
Veterans Affairs




one eighth inch = one

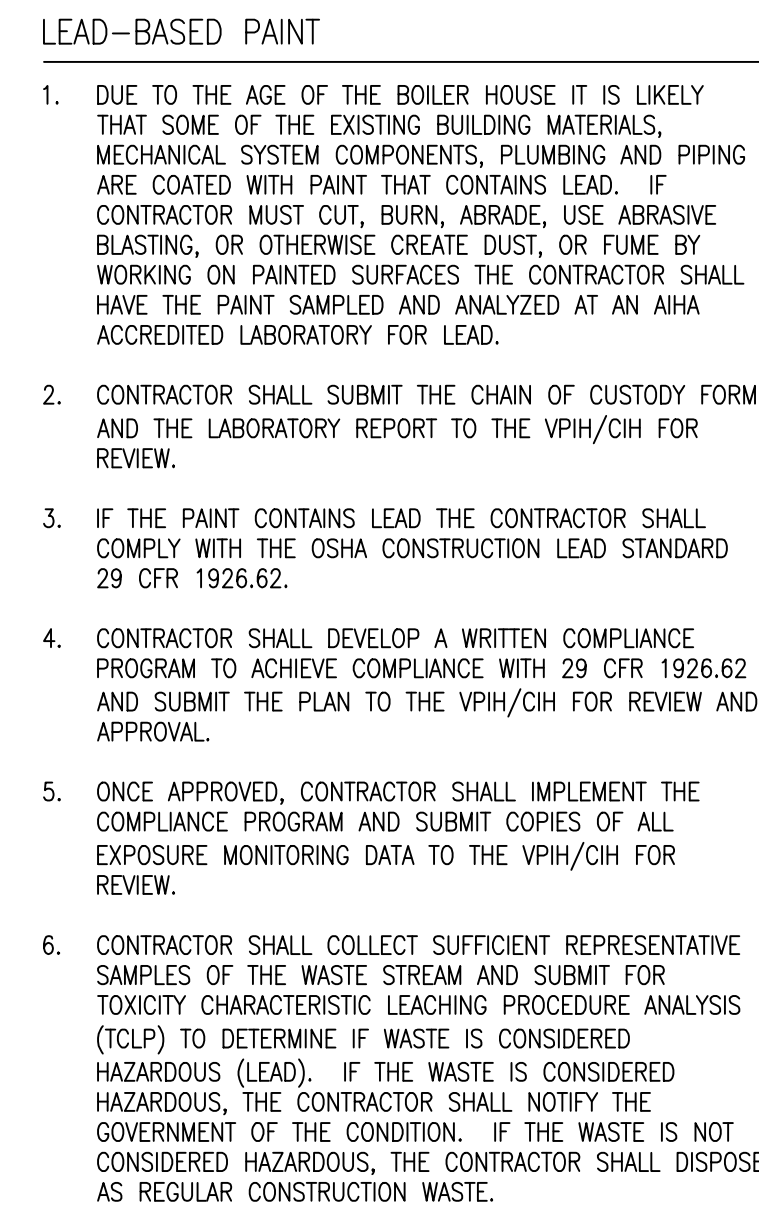

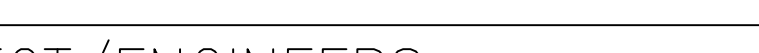		CONSULTANTS:		ARCHITECT/ENGINEERS:    600 North Hartley Street, Suite 150 T 717.843.3200 F 717.699.0205 www.saaarchitects.com	York, PA 17404 www.saaarchitects.com	Drawing Title FIRST FLOOR HAZARDOUS MATERIALS		Project Title BOILER PLANT UPGRADE PHASE V		Project Number 613-12-501		Office of Construction and Facilities Management  
						Approved: Project Director		Location VAMC MARTINSBURG, WV		Drawing Number 320		
						Date 10.22.13		Checked		Drawn		
Revisions:	Date									Dwg. 4 of 44		

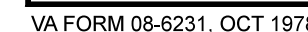

VA FORM 08-6231



Released Under the President John F. Kennedy Library Act, 1964, by the John F. Kennedy Library, Boston, MA 02128-1801. This document is in the public domain in the United States of America.

three inches = one foot

one and one half inches = one foot

one inch = one foot

three quarters inch = one foot

one half inch = one foot

three eighths inch = one foot

one eighth inch = one foot

one quarter inch = one foot

one eighth inch = one foot

one quarter inch = one foot

one eighth inch = one foot

one quarter inch = one foot

#### SCOPE OF WORK:

ABATEMENT OF HAZARDOUS MATERIALS SHALL BE CARRIED OUT ONLY WHERE THE ELEMENTS CONTAINING HAZARDOUS MATERIALS ARE DISTURBED, REMOVED, OR ALTERED.

ELEMENTS CONTAINING HAZARDOUS MATERIALS THAT ARE NOT DISTURBED, REMOVED, OR ALTERED AS PART OF THE PROJECT SHALL REMAIN IN PLACE.

SEE DEMOLITION DRAWINGS FOR COORDINATION.

#### ASBESTOS-CONTAINING MATERIALS:

THE FOLLOWING SYSTEMS OR ITEMS HAVE BEEN SAMPLED AND CONFIRMED TO CONTAIN ASBESTOS (ALSO SEE ASBESTOS SURVEY AND SAMPLING DRAWINGS HA101-HA104):

1. STEAM HEADER
2. CONDENSATE RETURN
3. STEAM SUPPLY TO FIRE HOUSE BETWEEN BOILERS 1 & 2
4. PUMPED CONDENSATE RETURN
5. IN-HOUSE STEAM SUPPLY
6. H. P. STEAM SUPPLY TO THE FIRE DEPARTMENT
7. BOILER FEED - SOUTH WALL
8. FORCED DRAFT FAN ROPE GASKET
9. BOILER BREACHINGS
10. BOILER STACKS
11. NOT USED
12. NOT USED
13. NOT USED
14. ROOFING ASPHALT
15. FLASHING ASPHALT
16. NOT USED

NO ASBESTOS WAS DETECTED IN THE SAMPLES COLLECTED FROM THE FOLLOWING:

1. DEAERATOR TANK AND ITS CANVAS JACKET
2. SURGE TANK.


EXISTING PIPE INSULATION SHALL BE REMOVED IN ACCORDANCE WITH SPECIFICATION SECTION 02 82 11 TRADITIONAL ASBESTOS ABATEMENT AND SECTION 02 82 13.13 GLOVEBAG ASBESTOS ABATEMENT.

ROOFING MATERIALS ARE CLASSIFIED AS CATEGORY I NONFRIABLE ASBESTOS-CONTAINING MATERIAL.

CONTRACTOR SHALL COMPLY WITH THE NATIONAL EMISSION STANDARDS FOR HAZARDOUS AIR POLLUTANTS (NESHAP) - EPA'S RULE TO CONTROL EMISSIONS OF ASBESTOS TO THE ENVIRONMENT (40 CFR PART 61, SUBPART M).

#### LEAD-BASED PAINT

1. DUE TO THE AGE OF THE BOILER HOUSE IT IS LIKELY THAT SOME OF THE EXISTING BUILDING MATERIALS, MECHANICAL SYSTEM COMPONENTS, PLUMBING AND PIPING ARE COATED WITH PAINT THAT CONTAINS LEAD. IF CONTRACTOR MUST CUT, BURN, ABRASE, USE ABRASIVE BLASTING, OR OTHERWISE CREATE DUST, OR FUME BY WORKING ON PAINTED SURFACES THE CONTRACTOR SHALL HAVE THE PAINT SAMPLED AND ANALYZED AT AN AHA ACCREDITED LABORATORY FOR LEAD.
2. CONTRACTOR SHALL SUBMIT THE CHAIN OF CUSTODY FORM AND THE LABORATORY REPORT TO THE VPH/CH FOR REVIEW.
3. IF THE PAINT CONTAINS LEAD THE CONTRACTOR SHALL COMPLY WITH THE OSHA CONSTRUCTION LEAD STANDARD 29 CFR 1926.62.
4. CONTRACTOR SHALL DEVELOP A WRITTEN COMPLIANCE PROGRAM TO ACHIEVE COMPLIANCE WITH 29 CFR 1926.62 AND SUBMIT THE PLAN TO THE VPH/CH FOR REVIEW AND APPROVAL.
5. ONCE APPROVED, CONTRACTOR SHALL IMPLEMENT THE COMPLIANCE PROGRAM AND SUBMIT COPIES OF ALL EXPOSURE MONITORING DATA TO THE VPH/CH FOR REVIEW.
6. CONTRACTOR SHALL COLLECT SUFFICIENT REPRESENTATIVE SAMPLES OF THE WASTE STREAM AND SUBMIT FOR TOXICITY CHARACTERISTIC LEACHING PROCEDURE ANALYSIS (TCLP) TO DETERMINE IF WASTE IS CONSIDERED HAZARDOUS (LEAD). IF THE WASTE IS CONSIDERED HAZARDOUS, THE CONTRACTOR SHALL NOTIFY THE GOVERNMENT OF THE CONDITION. IF THE WASTE IS NOT CONSIDERED HAZARDOUS, THE CONTRACTOR SHALL DISPOSE AS REGULAR CONSTRUCTION WASTE.

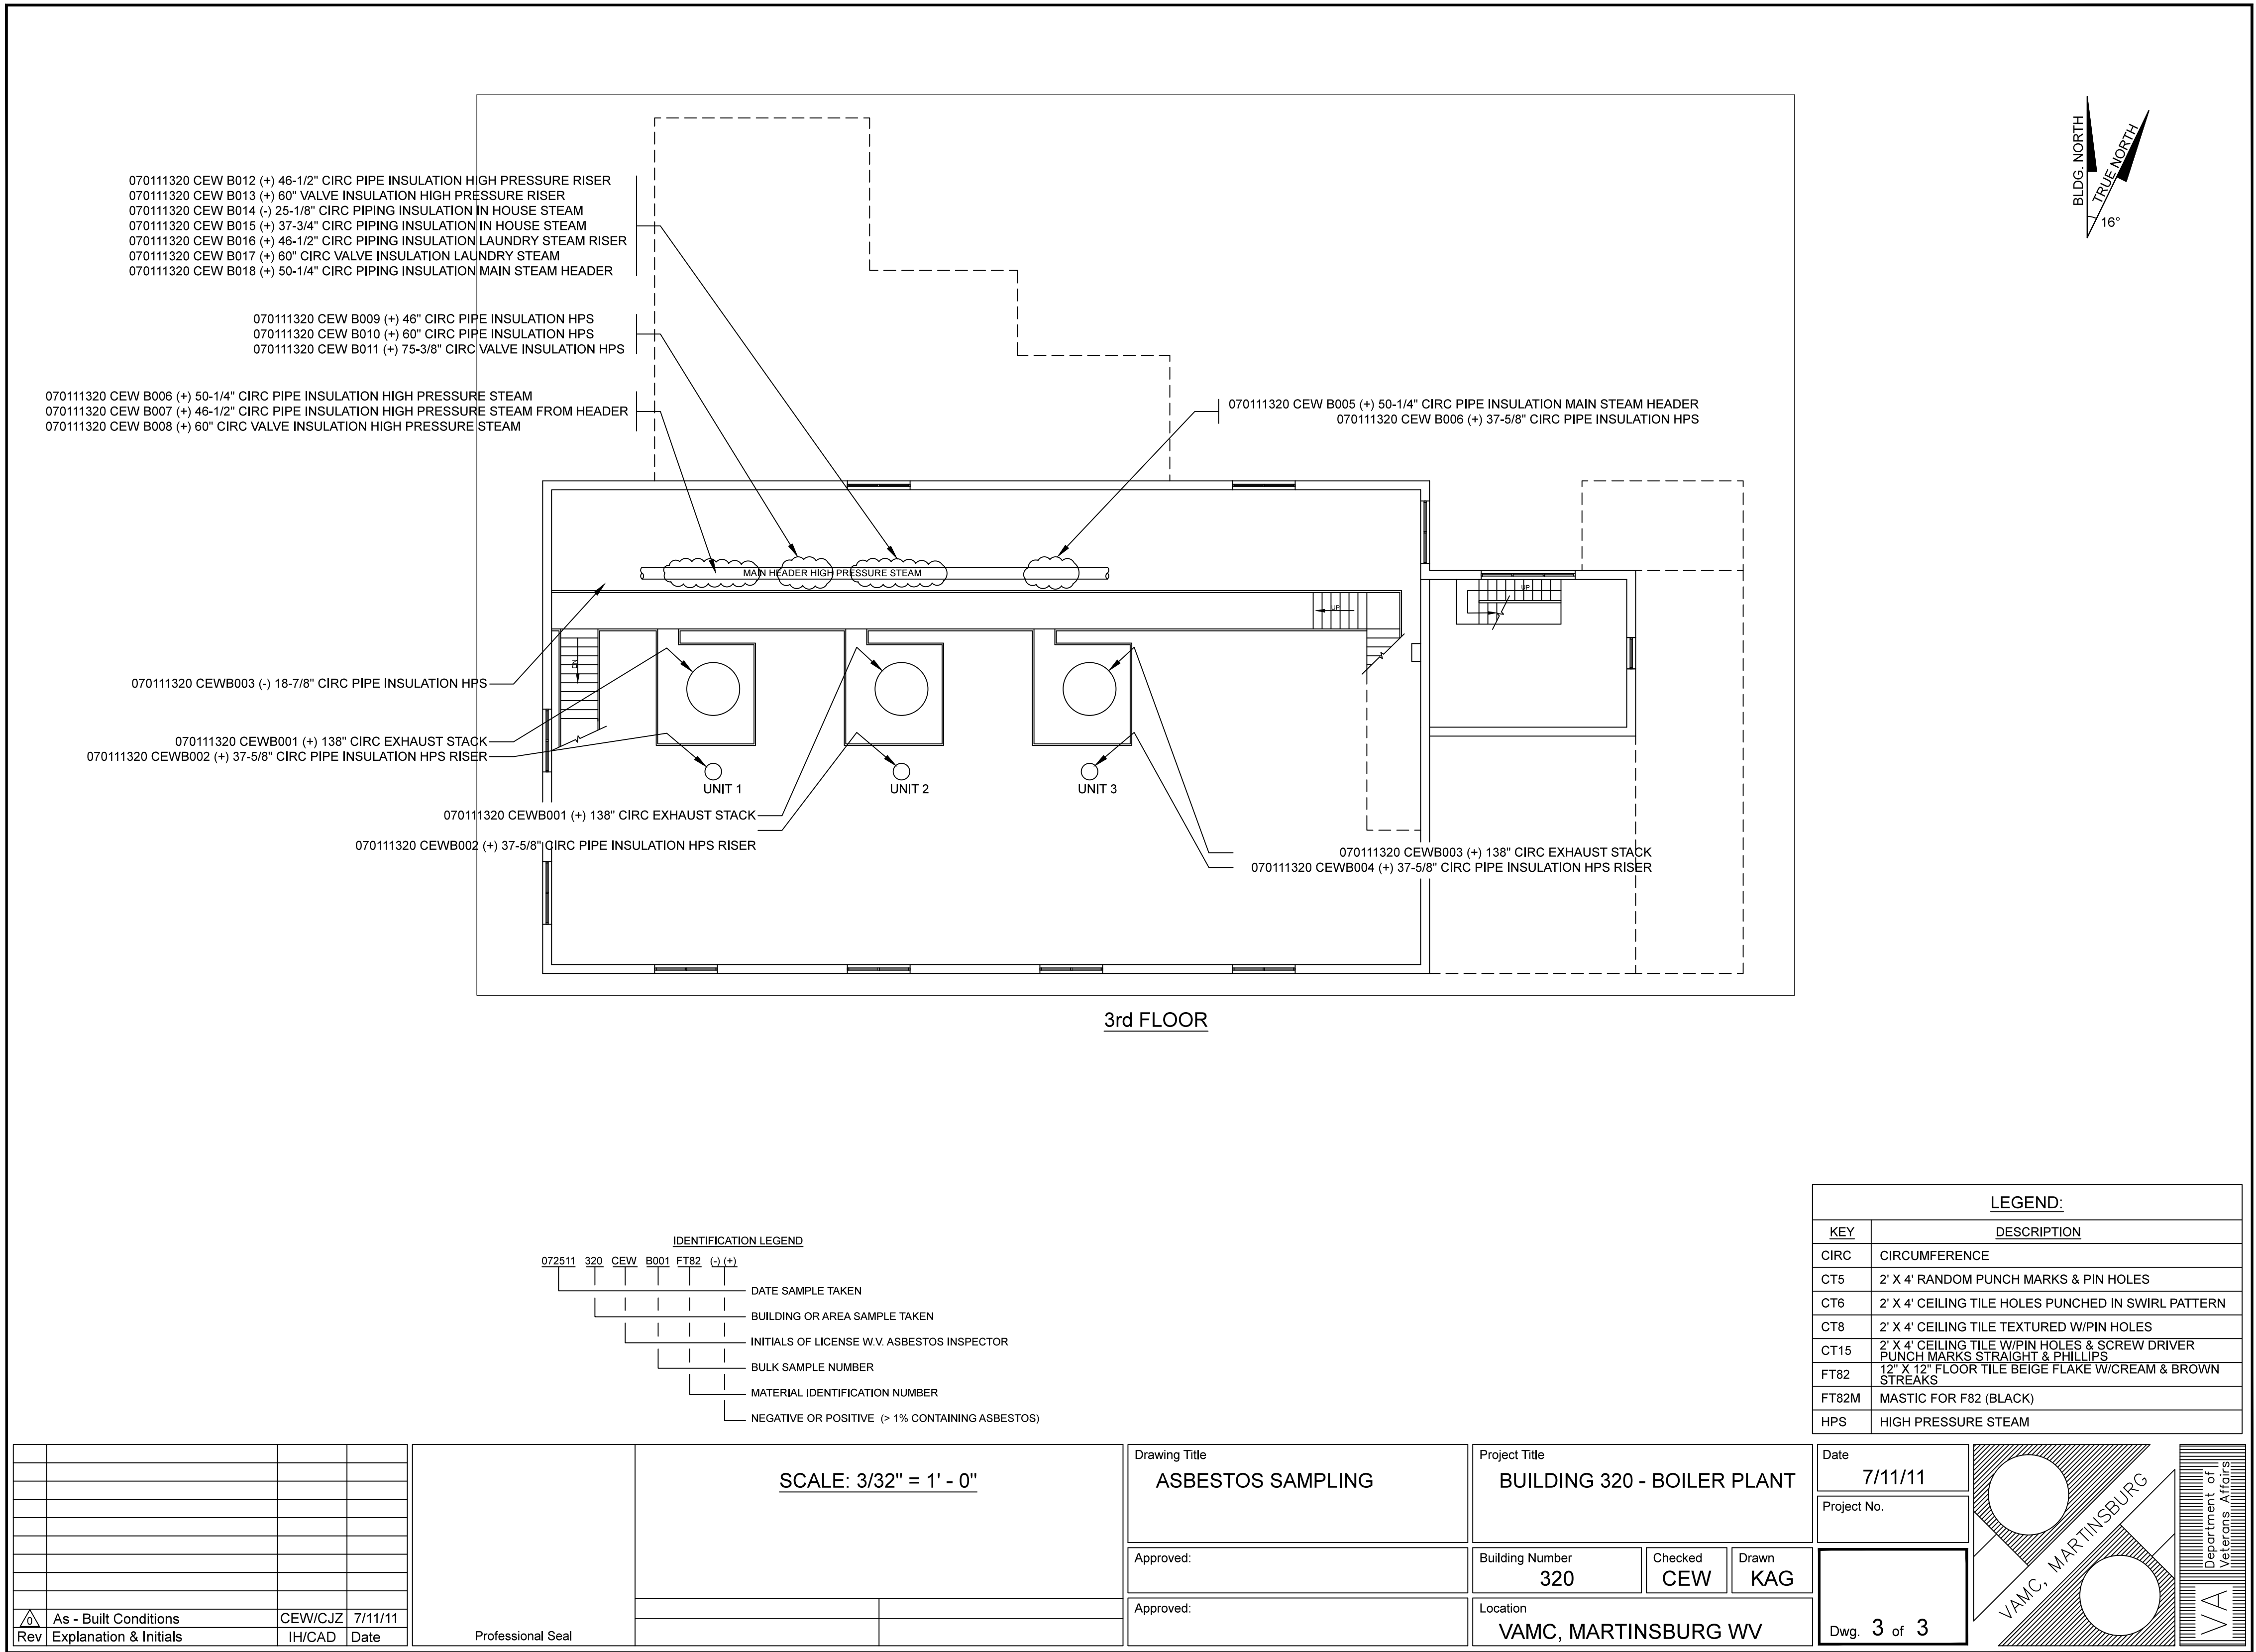

#### CONSULTANTS:

#### ARCHITECT/ENGINEERS:

**SAA**architects

600 North Hartley Street, Suite 150  
T 717.843.3200 F 717.699.0205

York, PA 17404  
www.saaarchitects.com

Drawing Title  
THIRD FLOOR HAZARDOUS MATERIALS

Project Title  
BOILER PLANT UPGRADE  
PHASE V

Project Number  
613-12-501

Building Number  
320


Drawing Number  
320-HA103

Dwg. 6 of 44

Office of  
Construction  
and Facilities  
Management

Department of  
Veterans Affairs



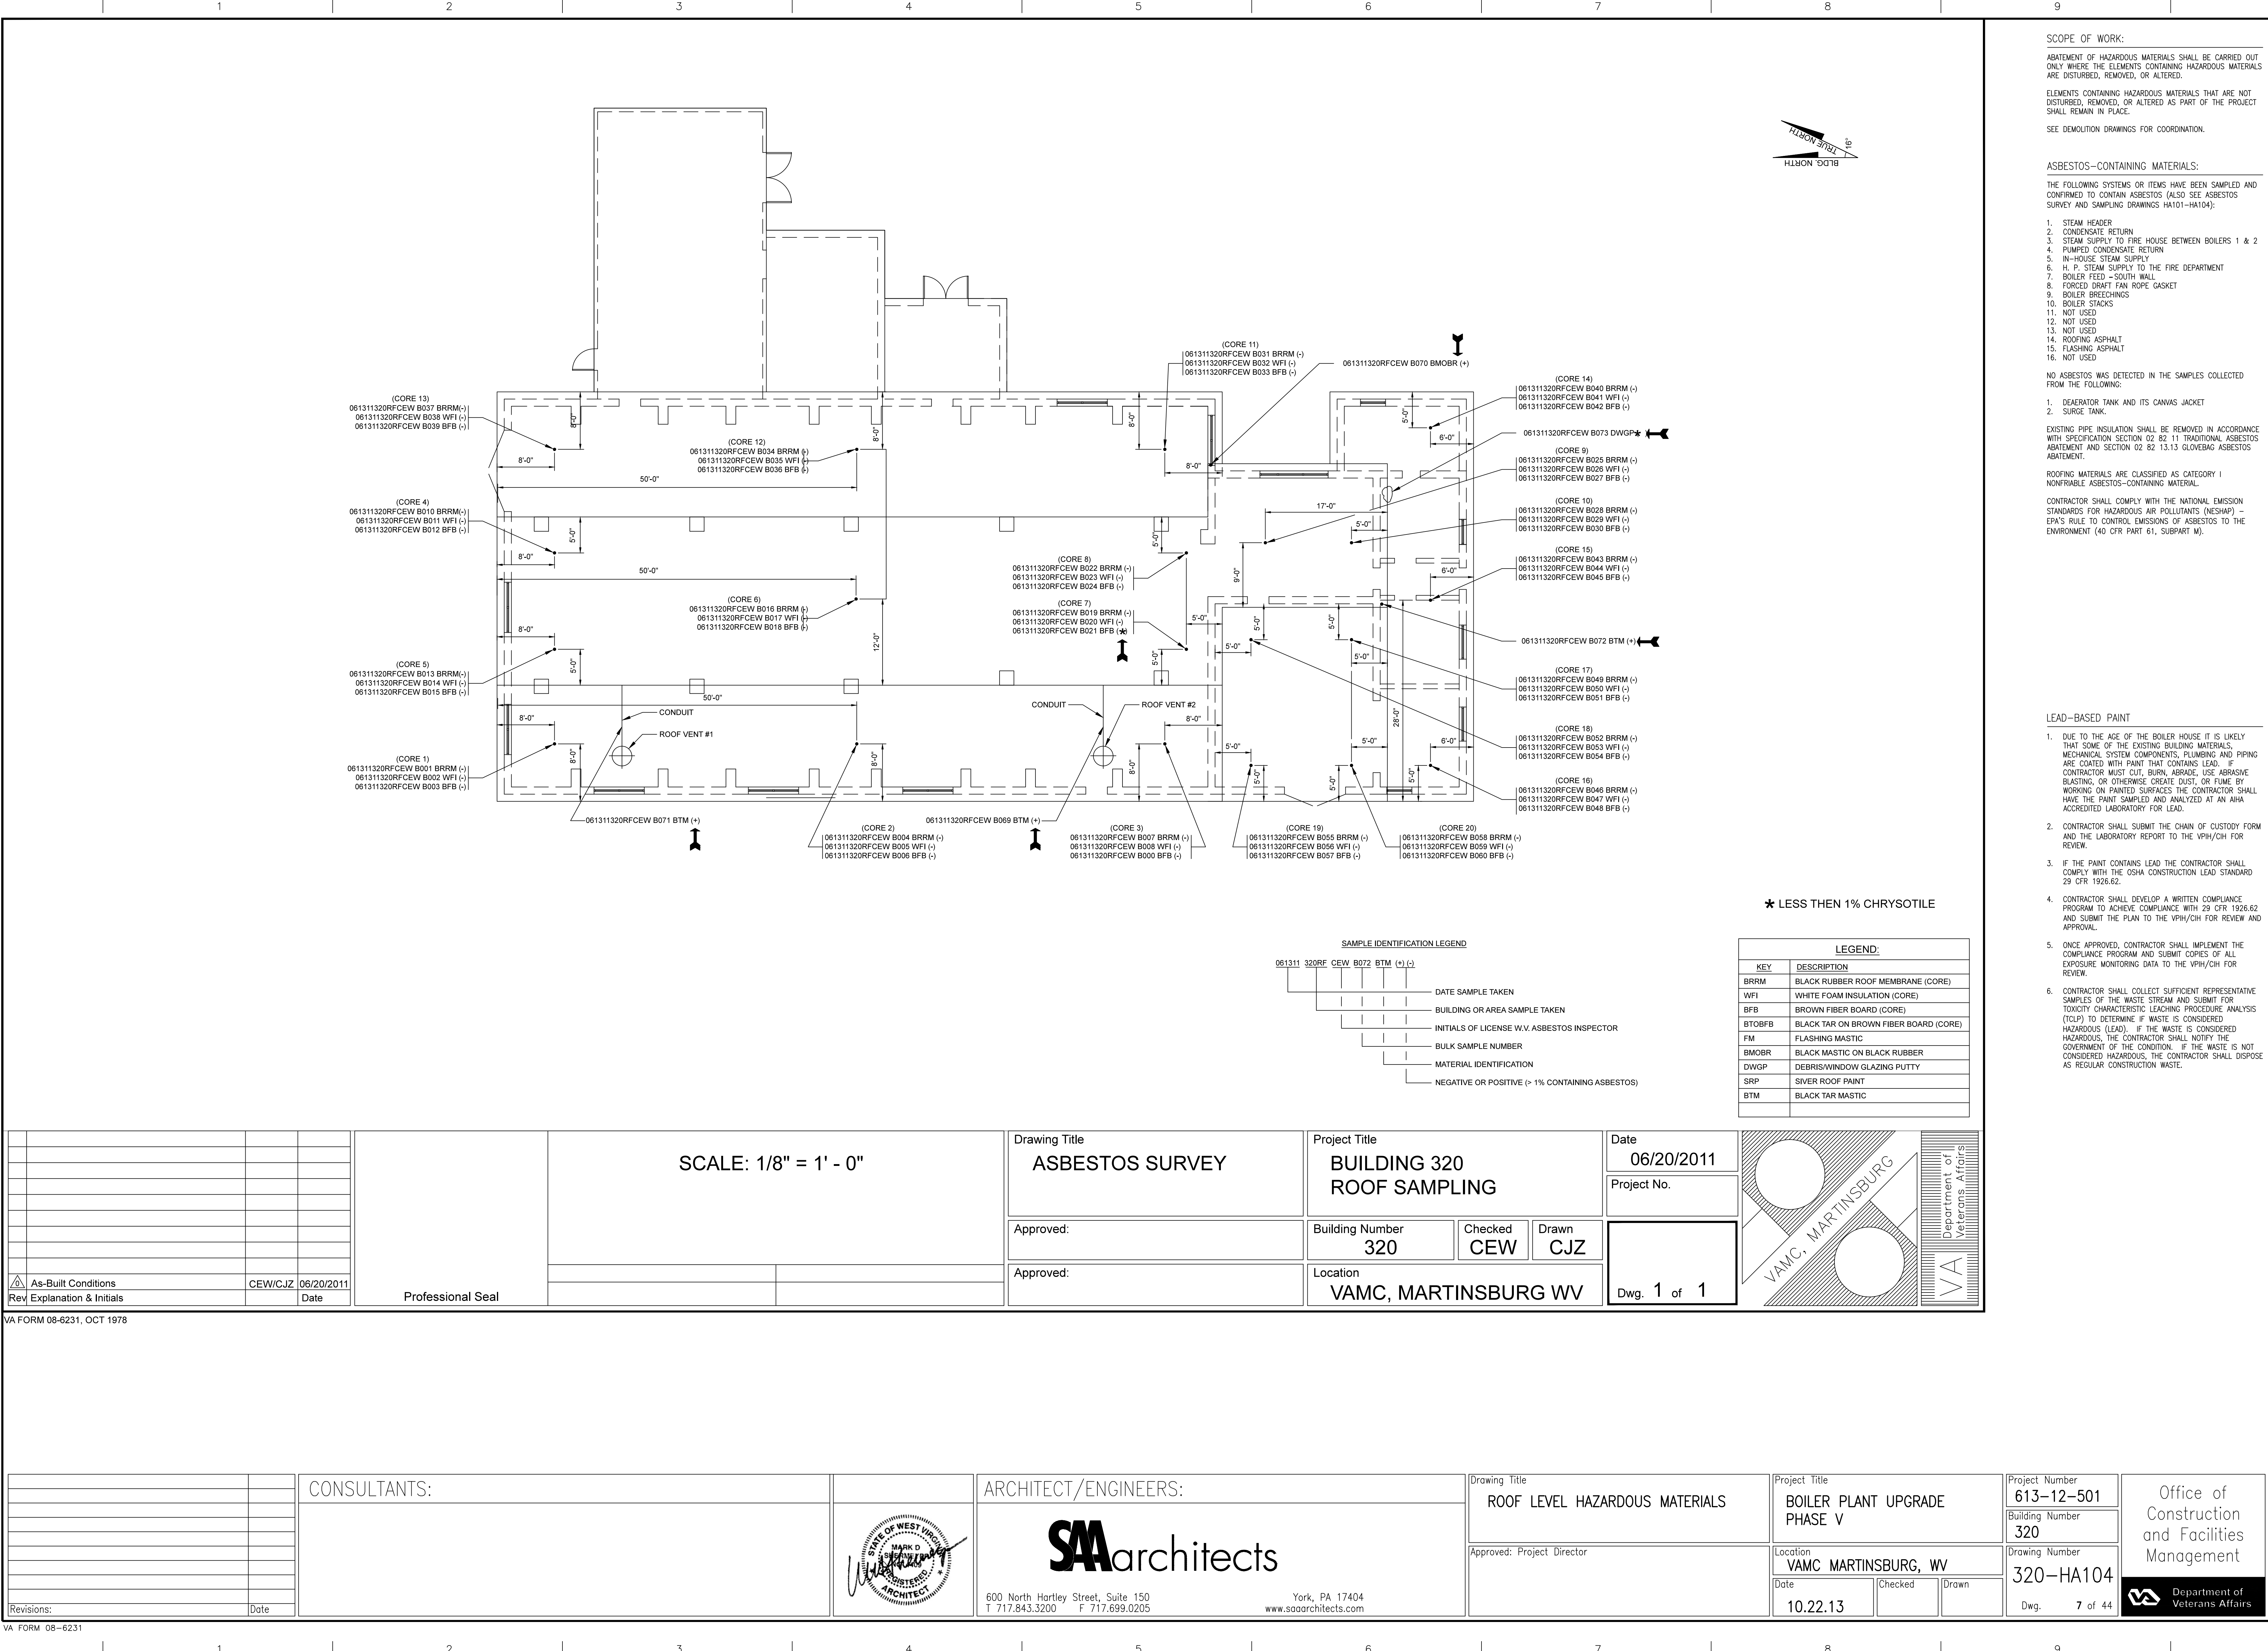

**ASBESTOS-CONTAINING MATERIALS:**

THE FOLLOWING SYSTEMS OR ITEMS HAVE BEEN SAMPLED AND  
CONFIRMED TO CONTAIN ASBESTOS (ALSO SEE ASBESTOS  
SURVEY AND SAMPLING DRAWINGS HA101-HA104):

1. STEAM HEADER
2. CONDENSATE RETURN
3. STEAM SUPPLY TO FIRE HOUSE BETWEEN BOILERS 1 & 2
4. PUMPED CONDENSATE RETURN
5. IN-HOUSE STEAM SUPPLY
6. H. P. STEAM SUPPLY TO THE FIRE DEPARTMENT
7. BOILER FEED - SOUTH WALL
8. FORCED DRAFT FAN ROPE GASKET
9. BOILER BREACHINGS
10. BOILER STACKS
11. NOT USED
12. NOT USED
13. NOT USED
14. ROOFING ASPHALT
15. FLASHING ASPHALT
16. NOT USED

NO ASBESTOS WAS DETECTED IN THE SAMPLES COLLECTED  
FROM THE FOLLOWING:

1. DEARATOR TANK AND ITS CANVAS JACKET
2. SURGE TANK.

EXISTING PIPE INSULATION SHALL BE REMOVED IN ACCORDANCE  
WITH SPECIFICATION SECTION 02 82.11 TRADITIONAL ASBESTOS  
SURFACE AND SECTION 02 82 13 GLASS/BALE ASBESTOS  
ABATEMENT.

ROOFING MATERIALS ARE CLASSIFIED AS CATEGORY 1  
NONFRIABLE ASBESTOS-CONTAINING MATERIAL.

CONTRACTOR SHALL COMPLY WITH THE NATIONAL EMISSION  
STANDARDS FOR HAZARDOUS AIR POLLUTANTS (NESHAP) -  
EPA'S RULE TO CONTROL EMISSIONS OF ASBESTOS TO THE  
ENVIRONMENT (40 CFR PART 61, SUBPART M).

## LEAD-BASED PAINT

1. DUE TO THE AGE OF THE BOILER HOUSE IT IS LIKELY THAT SOME OF THE EXISTING BUILDING MATERIALS, MECHANICAL SYSTEM COMPONENTS, PLUMBING AND PIPING ARE COATED WITH PAINT THAT CONTAINS LEAD. IF CONTRACTOR MUST CUT, BURN, ABRASE, USE ABRASIVE-BLASTING, OR OTHERWISE CREATE DUST, OR FLAME BY WORKING ON PAINTED SURFACES THE CONTRACTOR SHALL HAVE THE PAINT SAMPLED AND ANALYZED AT AN AHA ACCREDITED LABORATORY FOR LEAD.
2. CONTRACTOR SHALL SUBMIT THE CHAIN OF CUSTODY FORM AND THE LABORATORY REPORT TO THE VPIH/CIH FOR REVIEW.
3. IF THE PAINT CONTAINS LEAD THE CONTRACTOR SHALL COMPLY WITH THE OSHA CONSTRUCTION LEAD STANDARD 29 CFR 1926.62.
4. CONTRACTOR SHALL DEVELOP A WRITTEN COMPLIANCE PROGRAM TO ACHIEVE COMPLIANCE WITH 29 CFR 1926.62 AND SUBMIT THE PLAN TO THE VPIH/CIH FOR REVIEW AND APPROVAL.
5. ONCE APPROVED, CONTRACTOR SHALL IMPLEMENT THE COMPLIANCE PROGRAM AND SUBMIT COPIES OF ALL EXPOSURE MONITORING DATA TO THE VPIH/CIH FOR REVIEW.
6. CONTRACTOR SHALL COLLECT SUFFICIENT REPRESENTATIVE SAMPLES OF THE WASTE STREAM AND SUBMIT FOR TOXICITY CHARACTERISTIC LEACHING PROCEDURE ANALYSIS (TCLP) TO DETERMINE IF WASTE IS CONSIDERED HAZARDOUS (LEAD). IF THE CONTRACTOR IS CONSIDERED HAZARDOUS, THE CONTRACTOR SHALL NOTIFY THE GOVERNMENT OF THE CONDITION. IF THE WASTE IS NOT HAZARDOUS, THE CONTRACTOR SHALL DISPOSE AS REGULAR CONSTRUCTION WASTE.

LEGEND:	
KEY	DESCRIPTION
BRRM	BLACK RUBBER ROOF MEMBRANE (CORE)
WFI	WHITE FOAM INSULATION (CORE)
BFB	BROWN FIBER BOARD (CORE)
BTBFB	BLACK TAR ON BROWN FIBER BOARD (CORE)
FM	FLASHING MASTIC
BMOBR	BLACK MASTIC ON BLACK RUBBER
DWGP	DEBRIS/WINDOW GLAZING PUTTY
SRP	SILVER ROOF PAINT
BTM	BLACK TAR MASTIC

\* LESS THEN 1% CHRYSOTILE

SCALE: 1/8" = 1' - 0"

Drawing Title

**ASBESTOS SURVEY**

Project Title

**BUILDING 320  
ROOF SAMPLING**

Date	06/20/2011
Project No.	

Project No.

Building Number <b>320</b>	Checked <b>CEW</b>	Drawn <b>CJZ</b>
-------------------------------	-----------------------	---------------------

Location  
VAMC, MARTINSBURG WV

Dwg. 1 of 1

△	As-Built Conditions	CEW/CJZ	06/20/2011
Rev	Explanation & Initials		Date

Professional Seal

VA FORM 08-6231, OCT 1978

CONSULTANTS:



ARCHITECT/ENGINEERS:

**SAA**architects

600 North Hartley Street, Suite 150  
T 717.843.3200 F 717.699.0205

York, PA 17404  
www.sagarchitects.com

Drawing Title
ROOF LEVEL HAZARDOUS MATERIALS

Approved: Project Director

Project Title	BOILER PLANT UPGRADE PHASE V
---------------	---------------------------------

Location  
VAMC MARTINSBURG, WV

Date  
10/22/13

Project Number	613-12-501
Building Number	320

Drawing Number	320 IIA104
----------------	------------

Dwg: 7 of 44

Office of  
Construction  
and Facilities  
Management

